

WAYNE  
 0174  
 2-73

MISSISSIPPI  
 BOARD OF WATER COMMISSIONERS  
 416 North State Street  
 Jackson, Mississippi 39201

**CODED**

WATER WELL DRILLERS LOG

19 M<sup>c</sup>ILWAIN WATER WELL SER. WAYNE

date well completed

firm name

county well located

LANDOWNER:  
J. & J. ENTERPRISES  
Pt 2 WAYNESBORO  
 (mailing address)

WELL LOCATION:  
 sec. 2 T. 8 N. R. 6 E.  
5 miles E of W<sup>B</sup>ORO  
 (distance) (direction) (nearest town)

description of formations encountered	from	to
<u>Red Clay</u>	<u>0</u>	<u>18</u>
<u>Grey Clay</u>	<u>18</u>	<u>25</u>
<u>sand</u>	<u>25</u>	<u>42</u>
<u>rock</u>	<u>42</u>	<u>42½</u>
<u>Clay &amp; sand</u>	<u>42½</u>	<u>60</u>
<u>sand</u>	<u>60</u>	<u>81</u>

WELL PURPOSE: LIVESTOCK  
 (home, irrigation, municipal, industrial)

WELL COMPLETION DATA:

(1) diameter (inches) 2"

(2) total depth (feet) 81'

(3) static water level (feet) 36' below top of ground.

(4) casing PVC 71'  
 (material) (depth)  
2"  
 (size) if telescope see back.

(5) screen 10' 71'  
 (length) (depth to top)  
2" PVC .008  
 (size) (material)

(6) pump 2 12  
 (HP) (yield gpm)  
220 AC  
 (type power)

(7) electric log 710  
 (yes or no)

(organization running log)

(8) how well bottom plugged


**CODED**

DATE 2 10 73  
 IMPR 3 1373

DRILLERS REMARKS:

If well telescopes please sketch and show depths.

GROUND LEVEL

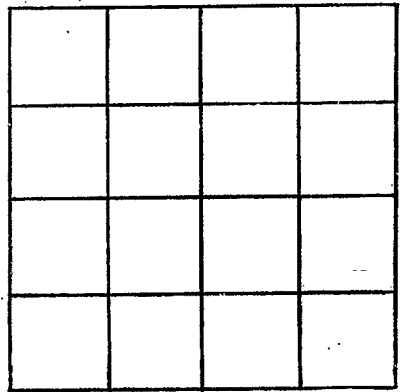

SECTION \_\_\_\_\_

Please indicate well location X.

ADDITIONAL INFORMATION

If more than one screen,  
show locations of each on sketch.