

WAYNE
 176
 3-14-73

MISSISSIPPI
 BOARD OF WATER COMMISSIONERS
 416 North State Street
 Jackson, Mississippi 39201

CODED

WATER WELL DRILLERS LOG

3-14-73 date well completed 19 McILWAIN WATER WELL SER. firm name WAYNE county well located

LANDOWNER:
 NORMAN BISHOP
 Rt 2 WAYNESBORO
 (mailing address)

description of formations encountered	from	to
Red Clay	0	12
Pink Clay	12	16
Sandy Clay	16	25
Sand	25	58

WELL LOCATION:
 sec. 3 T. 8 N R. 6 E
 5 miles E of W'BORO
 (distance) (direction) (nearest town)

WELL PURPOSE: HOME
 (home, irrigation, municipal, industrial)

- WELL COMPLETION DATA:
- (1) diameter (inches) 2"
 - (2) total depth (feet) 58
 - (3) static water level (feet) 25 below top of ground.
 - (4) casing PVC, 48' (material) (depth)
 2" (size) if telescope see back.
 - (5) screen 10' 48' (length) (depth to top)
 2" PVC .008, .010 (size) (material)
 - (6) pump 1 13+ (HP) (yield gpm)
 220 AC (type power)
 - (7) electric log 710 (yes or no)
- (organization running log)
- (8) how well bottom plugged


CODED

DRILLERS REMARKS:

APR 21 1973
 APR 20 1973

If well telescopes please sketch and show depths.

GROUND LEVEL

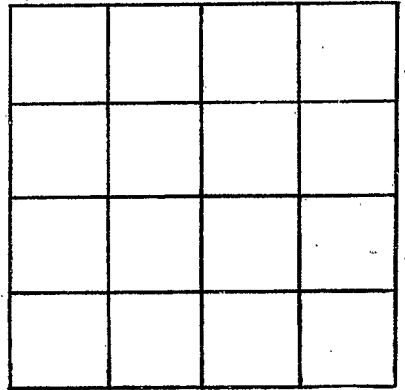

SECTION _____

Please indicate well location X.

ADDITIONAL INFORMATION

If more than one screen,
show locations of each on sketch.