

WAYNE  
 0177  
 4-17-73

MISSISSIPPI  
 BOARD OF WATER COMMISSIONERS  
 416 North State Street  
 Jackson, Mississippi 39201

CODED

WATER WELL DRILLERS LOG


4-17-73 date well completed  
 MILLWAIN WATER WELL SER firm name  
 WAYNE county well located

LANDOWNER:	description of formations encountered	from	to
E. L. MAYFIELD			
ROUTE 4, WAYNESBORO (mailing address)	WHITE CLAY	8	12
WELL LOCATION: sec. 27 T. 8 N R. 6 W	SAND AND CLAY STREAKS	12	29
5 miles SE of W'BORO (distance) (direction) (nearest town)	COARSE SAND	29	45
WELL PURPOSE: HOME (home, irrigation, municipal, industrial)			
WELL COMPLETION DATA:			
(1) diameter (inches) 2"			
(2) total depth (feet) 45'			
(3) static water level (feet) 27' below top of ground.			
(4) casing PVC 40' (material) (depth)			
2" If telescope see back. (size)			
(5) screen 5' 40' (length) (depth to top)			
2" PVC 1008 (size) (material)			
(6) pump 1 10 (HP) (yield gpm)			
220 AC (type power)			
(7) electric log NO (yes or no)			
(organization running log)			
(8) how well bottom plugged			
DRILLERS REMARKS:			

CODED

If well telescopes please sketch and show depths.

GROUND LEVEL

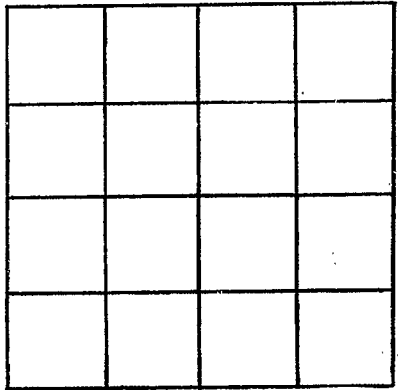

SECTION \_\_\_\_\_

Please indicate well location X.

ADDITIONAL INFORMATION

If more than one screen, show locations of each on sketch.