

WAYNE

0178

5-22-73

MISSISSIPPI BOARD OF WATER COMMISSIONERS
416 North State Street
Jackson, Mississippi 39201

CODED

WATER WELL DRILLERS LOG

May 22 1973 Rich Drilling Co. Wayne
date well completed firm name county well located

LANDOWNER Eddie Dick

description of formations encountered

from

to

at W Waynesboro
(mailing address)

red clay & sand 0 15
Coarse sand 15 36
Chalk 36 50
fine sand 50 76
fine sand & chalk 76 77
lighter chalk

WELL LOCATION:

sec. 11 T 80 N R 6 E W
2 miles SE of Waynesboro
(distance) (direction) (nearest town)

WELL PURPOSE: water
(home, irrigation, municipal, industrial)

WELL COMPLETION DATA:

- (1) diameter (inches) 2"
- (2) total depth (feet) 76'
- (3) static water level (feet) 68' below above top of ground.
- (4) casing steel 71'
(material) (depth)
- 2" if telescope see back.
(size)
- (5) screen 5' 71'
(length) (depth to top)
- 1 1/2" log ss.
(size) (material)
- (6) pump none set
(HP) (yield gpm)

5' 1 1/2" log ss.
screened on end of casing

CODED

(type power)
(7) electric log no
(yes or no)
(organization running log)


(8) how well bottom plugged
flush ground

DRILLERS REMARKS:

MAY 25 1973

If well telescopes please sketch and show depths.

GROUND LEVEL

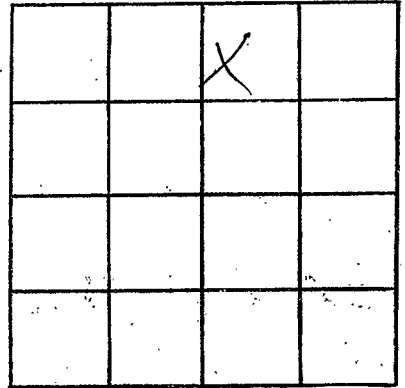

SECTION 17

Please indicate well location X.

ADDITIONAL INFORMATION

If more than one screen,
show locations of each on sketch.