

**MISSISSIPPI  
BOARD OF WATER COMMISSIONERS**  
416 North State Street  
Jackson, Mississippi 39201

**CODED**

**WAYNE**  
**Ø 179**  
**5-26-73**

**WATER WELL DRILLERS LOG**

**5-26-73** 19 **MR ILWAN WATER WELL SER.** **WAYNE**  
date well completed firm name county well located


LANDOWNER:	description of formations encountered	from	to
<b>LED JONES</b>			
<b>RT 4 WAYNESBORO</b> (mailing address)	<b>Sand</b>	<b>12</b>	<b>23</b>
<b>WELL LOCATION:</b>	<b>Clay</b>	<b>23</b>	<b>51</b>
sec. <b>11</b> T. <b>8</b> N R. <b>6</b> E <b>8</b> miles (distance) <b>E</b> (direction) of <b>W'BORO</b> (nearest town)	<b>Sand</b>	<b>51</b>	<b>75</b>
<b>WELL PURPOSE:</b> <b>HOME</b> (home, irrigation, municipal, industrial)			
<b>WELL COMPLETION DATA:</b>			
(1) diameter (inches) <b>2"</b>			
(2) total depth (feet) <b>75</b>			
(3) static water level (feet) <b>56'</b> below top of ground.			
(4) casing <b>PVC</b> <b>65'</b> (material) (depth)			
<b>2"</b> (size) if telescope see back.			
(5) screen <b>10'</b> <b>65'</b> (length) (depth to top)			
<b>2"</b> <b>PVC .008</b> (size) (material)			
(6) pump <b>1</b> <b>10</b> (HP) (yield gpm)			
<b>110 AC</b> (type power)			
(7) electric log <b>NA</b> (yes or no)			
(organization running log)			
(8) how well bottom plugged			
<b>DRILLERS REMARKS:</b>			

**CODED**

**MAY 18 1973**

If well telescopes please sketch and show depths.

GROUND LEVEL

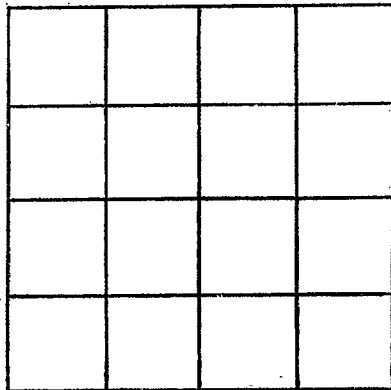

SECTION \_\_\_\_\_

Please indicate well location X.

ADDITIONAL INFORMATION

If more than one screen, show locations of each on sketch.