

WAYNE
 180
 3-7-73

MISSISSIPPI BOARD OF WATER COMMISSIONERS
 C. P. CLARK WATER WELL DRILLING
 ROUTE 2
 416 North State Street
 JACKSON, MISSISSIPPI 39201
 LAUREL, MISS. 39440

WATER WELL DRILLERS LOG

CODED

3/7 1973 date well completed
 C.P. Clark firm name
 Wayne county well located

LANDOWNER: Charles Everett
Waynesboro, Miss

description of formations encountered	from	to
Red Sandy Clay	0	7
Sand	7	12
Clay	12	20
Sand	20	26
Sandy Clay	26	48
Sand	48	77

(mailing address)

WELL LOCATION:
 sec. 17 T. 8(N) R. 6(E)
1 miles West of Waynesboro
 (distance) (direction) (nearest town)

WELL PURPOSE: Home
 (home, irrigation, municipal, industrial)

WELL COMPLETION DATA:

- (1) diameter (inches) 2
- (2) total depth (feet) 77
- (3) static water level (feet) 65 below top of ground.
- (4) casing Galv chrom
 (material) (depth)

_____ if telescope see back.
 (size)

- (5) screen 5 , 72
 (length) (depth to top)
1/4 , Solid S.S. 006
 (size) (material)
- (6) pump 3/4 5
 (HP) (yield gpm)
220V
 (type power)
- (7) electric log No
 (yes or no)

_____ (organization running log)

- (8) how well bottom plugged BWV


DRILLERS REMARKS: Set jet
@ 67 ft
3 A FW
dump (new)

CODED

MAR 9 1973

If well telescopes please sketch and show depths.

GROUND LEVEL

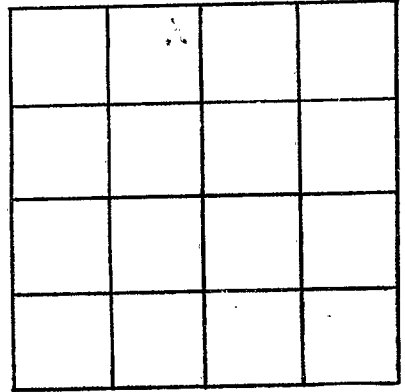

SECTION _____

Please indicate well location X.

ADDITIONAL INFORMATION

If more than one screen, show locations of each on sketch.