

WAYNE
 181
 7-10-73

MISSISSIPPI
 BOARD OF WATER COMMISSIONERS
 416 North State Street
 Jackson, Mississippi 39201

CODED

WATER WELL DRILLERS LOG

July 10 1973 *Rison Water Well Serv* *Wayne*
 date well completed firm name county well located

LANDOWNER:
Raymond Everett
RT 4, Box 34 Waynesboro, Miss
 (mailing address)

description of formations encountered	from	to
Top soil	0	1
White clay	1	8
Red clay	8	12
Red & white chunk	12	16
White & Blue chunk	16	28
Red med. coarse sand	28	35
Total	35	feet

WELL LOCATION:
 sec. 5 T 8 N R 6 E
5 miles East of Waynesboro
 (distance) (direction) (nearest town)

WELL PURPOSE: *Home*
 (home, irrigation, municipal, industrial)

- WELL COMPLETION DATA:
- (1) diameter (inches) 4"
 - (2) total depth (feet) 35'
 - (3) static water level (feet) 28' below above top of ground.
 - (4) casing 2" 32'
 (material) (depth)
 (size) if telescope see back.
 - (5) screen 3" 35'
 (length) (depth to top)
1/4" Brass screen
 (size) (material)
 - (6) pump 3/4 5
 (HP) (yield gpm)
Electric
 (type power)
 - (7) electric log no
 (yes or no)
 (organization running log)
 - (8) how well bottom plugged Drill -
Point


DRILLERS REMARKS: *Good*

CODED

AUG 9 1973

If well telescopes please sketch and show depths.

GROUND LEVEL

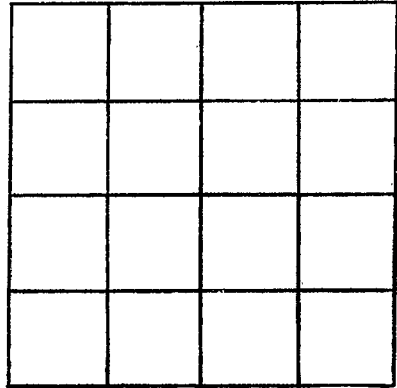

SECTION _____

Please indicate well location X.

ADDITIONAL INFORMATION

If more than one screen, show locations of each on sketch.