

CODED

MISSISSIPPI BOARD OF WATER COMMISSIONERS  
416 North State Street  
Jackson, Mississippi 39201

WAYNE  
Ø 185  
9-7-73

WATER WELL DRILLERS LOG

SEPT 7, 1973  
date well completed  
McILWAIN WATER WELL SERVICE WAYNE  
RI. 2, Box 37  
WAYNESBORO, MISS. 39386  
county well located

LANDOWNER:

ALVIN JORDAN  
RT 2 WAYNESBORO  
(mailing address)

WELL LOCATION:

sec. 5 T 8 N R 6 E  
2 miles of W'BORO  
(distance) (direction) (nearest town)

WELL PURPOSE:

HOME  
(home, irrigation, municipal, industrial)

WELL COMPLETION DATA:

- (1) diameter (inches) 2"
- (2) total depth (feet) 63'
- (3) static water level (feet) 35' below top of ground.
- (4) casing PVC 53' (material) (depth)  
2" (size) if telescope see back.
- (5) screen 10' 53' (length) (depth to top)  
2" PVC .008 (size) (material)
- (6) pump 3/4 9 (HP) (yield gpm)  
110 AC (type-power)
- (7) electric log NO (yes or no)

(organization running log)

(8) how well bottom plugged

description of formations encountered

from to


RED CLAY	0	8
RED SAND	8	12
WHITE SAND	12	19
WHITE CHALK	19	31
BLUE CLAY	31	49
COARSE SAND	49	63

DRILLERS REMARKS:

SEP 19 1973

If well telescopes please sketch and show depths.

GROUND LEVEL

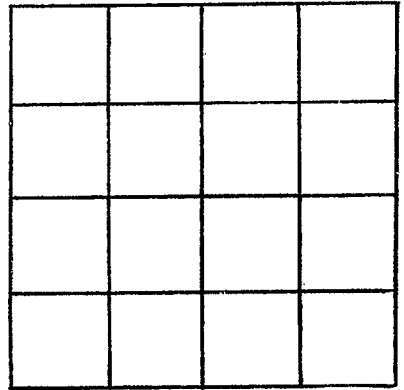

SECTION \_\_\_\_\_

Please indicate well location X.

ADDITIONAL INFORMATION

If more than one screen, show locations of each on sketch.