

WAYNE
 #186
 10-3-73

MISSISSIPPI
 BOARD OF WATER COMMISSIONERS
 416 North State Street
 Jackson, Mississippi 39201

CODED

WATER WELL DRILLERS LOG
 McILWAIN WATER WELL SERVICE

Oct 3, 1973
 date well completed

RT. 2, BOX 37
 WAYNESBORO, MISS, 39367

WAYNE
 county well located


LANDOWNER:	description of formations encountered	from	to
ARGIE SMITH	YELLOW CLAY	0	4
WAYNESBORO, MISS (mailing address)	FINE SAND	4	8
WELL LOCATION: sec. 20 T. 8 N R. 6 W 2 miles SE of W'BORO (distance) (direction) (nearest town)	COARSE SAND	COUDED 12	
WELL PURPOSE: HOME (home, irrigation, municipal, industrial)	GREY CLAY	12	28
WELL COMPLETION DATA: (1) diameter (inches) 2" (2) total depth (feet) 50' (3) static water level (feet) 14 1/2' below top of ground. (4) casing PVC 40' (material) (depth) 2" (size) if telescope see back. (5) screen 10' 40' (length) (depth to top) 2" PVC .008 (size) (material) (6) pump 1/2 HP 15 (HP) (yield gpm) 110 AC (type power) (7) electric log No (yes or no) (organization running log) (8) how well bottom plugged	SAND	28	50

DRILLERS REMARKS:

OCT 9 1973

If well telescopes please sketch and show depths.

GROUND LEVEL

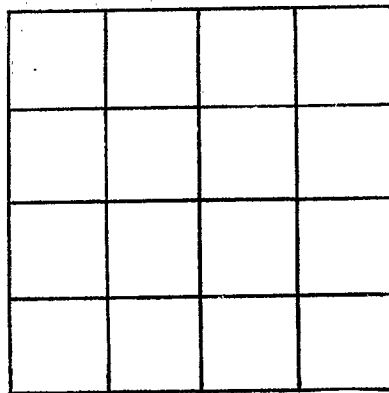

SECTION _____

Please indicate well location X.

ADDITIONAL INFORMATION

If more than one screen, show locations of each on sketch.