

WAYNE  
 187  
 9-25-73

MISSISSIPPI  
 BOARD OF WATER COMMISSIONERS  
 416 North State Street  
 Jackson, Mississippi 39201

CODED

WATER WELL DRILLERS LOG

SEPT 25, 1973, MCILWAIN WATER WELL SERVICE WAYNE  
 date well completed RT. 2, BOX 37 county well located

WAYNESBORO, MISS. 39367

LANDOWNER:  
 EARLEAN MORGAN  
 Rt 4 Waynesboro Miss.  
 (mailing address)

description of formations encountered

from to

WELL LOCATION:  
 sec. 10 T 8 N R 6 E  
 5 miles E of W' BORO  
 (distance) (direction) (nearest town)

RED CLAY AND SAND ROCK	0	4
PINK + WHITE CLAY	4	12
YELLOW + BROWN CLAY	12	25
RED SAND	25	28

WELL PURPOSE: HOME  
 (home, irrigation, municipal, industrial)

CLAY	28	31
------	----	----

WELL COMPLETION DATA:

(1) diameter (inches) 2"

(2) total depth (feet) 103'

(3) static water level (feet) 48' below top of ground.

(4) casing PVC 93' (material) (depth)  
 2" (size) If telescope see back.

(5) screen 10' 93' (length) (depth to top)  
 2" PVC .008 (size) (material)

(6) pump 1 12 (HP) (yield gpm)  
 220 AC (type power)

(7) electric log NO (yes or no)

(organization running log)

(8) how well bottom plugged


SAND + CLAY	31	35
WHITE CHALK	35	55
FINE SAND	55	65
SAND + CLAY STREAKS	65	90
MED. SAND	90	103

DRILLERS REMARKS:

MISSISSIPPI WATER COMMISSION

If well telescopes please sketch and show depths.

GROUND LEVEL

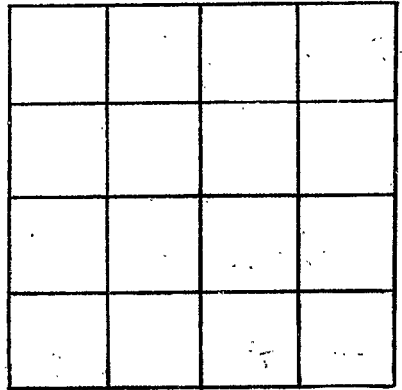

SECTION \_\_\_\_\_

Please indicate well location X.

ADDITIONAL INFORMATION

If more than one screen,  
show locations of each on sketch.