

WAYNE
 \$ 188
 10-1-73

MISSISSIPPI
 BOARD OF WATER COMMISSIONERS
 416 North State Street
 Jackson, Mississippi 39201

CODE

WATER WELL DRILLERS LOG

0 d 1 1973 Porte Drilling Inc Wayne
 date well completed firm name county well located

LANDOWNER: J. M. Whitney

description of formations encountered	from	to
red clay	0	12
sand & chalk	12	52
chalk	52	65
sand	65	72
strat on chalk		

At 2 Wamesboro Miss
 (failing address)

WELL LOCATION:
 sec. 11 T. 8 N. R. 6 E. S. 5
 (distance) miles (direction) (nearest town)
5 miles east of Wamesboro

WELL PURPOSE: home
 (home, irrigation, municipal, industrial)

WELL COMPLETION DATA:

- (1) diameter (inches) 2
- (2) total depth (feet) 72
- (3) static water level (feet) 47 below above top of ground.
- (4) casing P.V.C. 66'
 (material) (depth)
2' If telescope see back.
 (size)
- (5) screen 5' 66'
 (length) (depth to top)
1 1/2 Galat S.S.
 (size) (material)
- (6) pump 3/4 7
 (HP) (yield gpm)
elec.
 (type power)
- (7) electric log no
 (yes or no)

5' 1" 6" CODED
 sawed on end of case
 with steel from at about
 and back road valve
 on end.
60' 1" P.V.C. drop
pipe

(organization running log)


(8) how well bottom plugged back road valve

DRILLERS REMARKS:

067 9 1973

If well telescopes please sketch and show depths.

GROUND LEVEL

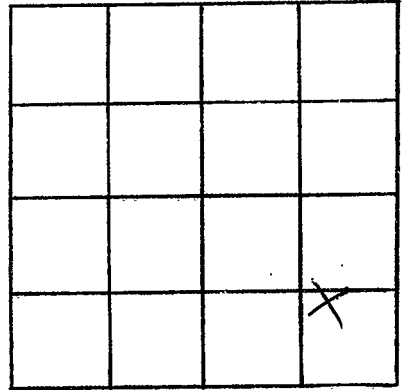

SECTION 11

Please indicate well location X.

ADDITIONAL INFORMATION

If more than one screen,
show locations of each on sketch.