

BOARD OF WATER COMMISSIONERS

416 North State Street  
Jackson, Mississippi 39201

WATER WELL DRILLERS LOG

WAYNE

191

11-21-73

Nov. 21 1973  
date well completed

Boyer Drilling & Pipe  
firm name

Wayne  
county well located

LANDOWNER: Boyer & Clark

description of formations encountered	from	to
	top soil	0
Chalk	2	8
sand	8	14
blue Chalk	14	31
rock strata	31	44
blue Chalk	44	57
rock strata	57	73
Chalk	73	78
fine sand	78	84
Chalk	84	86
sand & Chalk	86	95
fine clean sand	95	109
stop on Chalk		

Station St. Wagnersboro Miss  
(mailing address)

WELL LOCATION:  
sec 18 T 8 N R 6  
1 miles SE of Waynesboro  
(distance) (direction) (nearest town)

WELL PURPOSE: home  
(home, irrigation, municipal, industrial)

WELL COMPLETION DATA:

- (1) diameter (inches) 2"
- (2) total depth (feet) 109'
- (3) static water level (feet) 38' <sup>below</sup> <sub>above</sub> top of ground.
- (4) casing steel 102'  
(material) (depth)  
2' if telescope see back.  
(size)
- (5) screen 6' 103'  
(length) (depth to top)  
1 1/4" 80 ga S.S.  
(size) (material)
- (6) pump 1 12  
(HP) (yield gpm)  
elec  
(type power)
- (7) electric log no  
(yes or no)
- (organization running log)
- (8) how well bottom plugged flush joint

6' 1/4" 80 ga SS well  
2' 1/4" log pipe test  
in with graker  
6' 3/4" drop pipe


CODED

DRILLERS REMARKS:

DEC 12 1973

If well telescopes please sketch and show depths.

GROUND LEVEL

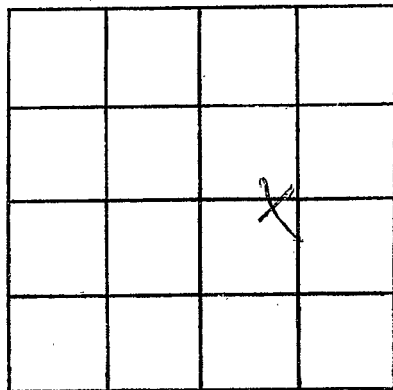

SECTION 18

Please indicate well location X.

ADDITIONAL INFORMATION

If more than one screen,  
show locations of each on sketch.