

WAYNE

Ø 192

12.15-73

MISSISSIPPI
 BOARD OF WATER COMMISSIONERS
 416 North State Street
 Jackson, Mississippi 39201

CODED

WATER WELL DRILLERS LOG

DEC. 15, 1973

McILWAIN WATER WELL SERVICE WAYNE

date well completed

RT. 2 Box 37

county well located

WAYNESBORO, MISS. 39367

LANDOWNER:

ROBERT DYESS (Camp)

RT. 2 WAYNESBORO, MISS.
(mailing address)

description of formations encountered

SAND

from

to

0

8

CLAY

8

13

WELL LOCATION:

sec. 21 T. 8 N R. 6 E
3 miles SE of W. BORO
(distance) (direction) (nearest town)

SAND

13

28

WELL PURPOSE: CAMP
(home, irrigation, municipal, industrial)

WELL COMPLETION DATA:

- (1) diameter (inches) 2"
- (2) total depth (feet) 28'
- (3) static water level (feet) 15' below top of ground.
- (4) casing PVC, 23' (material), (depth), 2" (size) if telescope see back.
- (5) screen 5' (length), 23' (depth to top), 2" (size), PVC .008 (material)
- (6) pump 1/2 (HP), 5 (yield gpm), 110 AC (type power)
- (7) electric log No (yes or no)

CODED

(organization running log)

(8) how well bottom plugged


DRILLERS REMARKS:

RECORDED
JAN 1 1974

MISS. Bd. OF WATER COMMISSIONERS

If well telescopes please sketch and show depths.

GROUND LEVEL

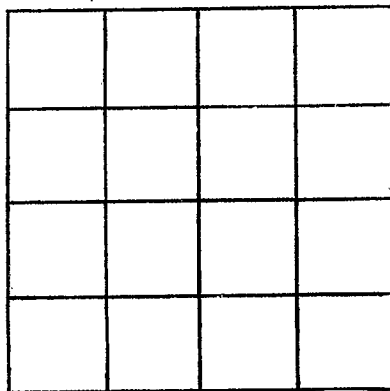

SECTION _____

Please indicate well location X.

ADDITIONAL INFORMATION

If more than one screen,
show locations of each on sketch.