

WAYNE
 P 193
 3-2-74

MISSISSIPPI
 BOARD OF WATER COMMISSIONERS
 416 North State Street
 Jackson, Mississippi 39201

CODED.

WATER WELL DRILLERS LOG

MARCH 2 1974 MS ILWAIN WATER WELL SER. WAYNE
 date well completed firm name county well located

LANDOWNER:
 CURTIS JONES
 WAYNESBORO, MISS.
 (mailing address)


WELL LOCATION:
 sec. 17 T 8 N R 6 E W 2
 (distance) miles (direction) of (nearest town)

WELL PURPOSE: HOME
 (home, irrigation, municipal, industrial)

- WELL COMPLETION DATA:
- (1) diameter (inches) 2"
 - (2) total depth (feet) 48'
 - (3) static water level (feet) 25' below top of ground.
 - (4) casing PVC 38' (material), (depth)
 2" (size) if telescope see back.
 - (5) screen 10' 38' (length), (depth to top)
 2" (size), PVC .008 (material)
 - (6) pump 1 10 (HP), (yield gpm)
 220 AC (type power)
 - (7) electric log NO (yes or no)
- (organization running log)
- (8) how well bottom plugged

description of formations encountered	from	to
Red Clay	0	12
Red Sand	12	20
Clay	20	22
sand + Clay Strata	22	30
Sand	30	48

CODED.

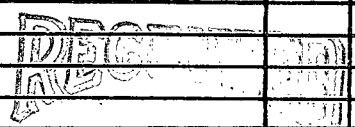


APR - 1 1974

DRILLERS REMARKS:

MISS. BD. OF WATER COMM.

If well telescopes please sketch and show depths.

GROUND LEVEL

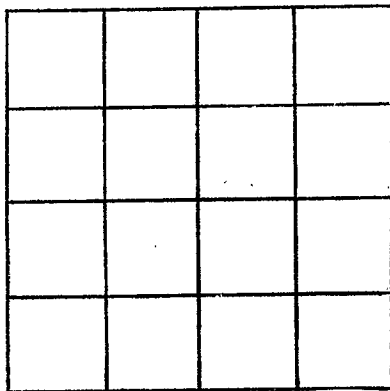

SECTION _____

Please indicate well location X.

ADDITIONAL INFORMATION

If more than one screen, show locations of each on sketch.