

WAYNE
 196
 5-1-74

MISSISSIPPI
 BOARD OF WATER COMMISSIONERS CODED
 416 North State Street
 Jackson, Mississippi 39201

WATER WELL DRILLERS LOG

MAY 1, 1974 19 McILWAIN WATER WELL SERVICE WAYNE
 date well completed RT. 2 BOX 37 county well located
 WAYNESBORO, MISS. 39367

LANDOWNER:

HENRY KIRKWOOD
 RT 2 WAYNESBORO, Miss.
 (mailing address)

| description of formations encountered | from | to |
|---------------------------------------|------|----|
| RED CLAY | 0 | 8 |
| SAND | 8 | 20 |
| CLAY | 20 | 21 |
| SAND | 21 | 23 |
| CLAY | 23 | 36 |
| SAND AND CLAY | 36 | 46 |
| SAND | 46 | 62 |

WELL LOCATION:

sec. 2 T 8 N R 6 E
 6 miles E of WAYNESBORO
 (distance) (direction) (nearest town)

WELL PURPOSE: HOME
 (home, irrigation, municipal, industrial)

WELL COMPLETION DATA:


- (1) diameter (inches) 2"
- (2) total depth (feet) 62'
- (3) static water level (feet) 25' below top of ground.
- (4) casing PVC 52' (material) (depth)
 2" (size) if telescope see back.
- (5) screen 10' 52 (length) (depth to top)
 2" PVC .008 (size) (material)
- (6) pump 1 (HP) 9 (yield gpm)
 110 AC (type power)
- (7) electric log NO (yes or no)

(organization running log)

(8) how well bottom plugged


DRILLERS REMARKS:

CODED

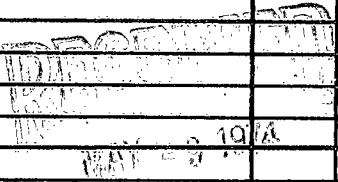

If well telescopes please sketch and show depths.

GROUND LEVEL

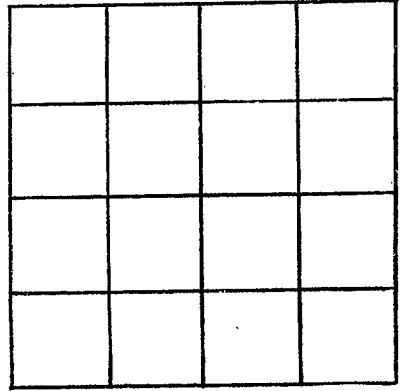

SECTION _____

Please indicate well location X.

ADDITIONAL INFORMATION

Lined area for additional information, consisting of 18 horizontal lines.

If more than one screen, show locations of each on sketch.