

WAYNE
 198
 5-7-74

MISSISSIPPI
 BOARD OF WATER COMMISSIONERS
 416 North State Street
 Jackson, Mississippi 39201

CODED

WATER WELL DRILLERS LOG

McILWAIN WATER WELL SERVICE WAYNE

May 7, 1974
 date well completed

RI. # BOX 37

county well located

WAYNESBORO, MISS. 39367

LANDOWNER:

GEORGE SHAW JR.
 WAYNESBORO, MISS.
 (mailing address)

description of formations encountered

from to

RED CLAY	0	5
SANDY CLAY	5	9
WHITE SAND AND CLAY STREAKS	9	30
MED SAND	30	40

WELL LOCATION:

sec. 20 T. 8 N R. 6 E
 2 miles SW of W BORO
 (distance) (direction) (nearest town)

WELL PURPOSE: HOME
 (home, irrigation, municipal, industrial)

WELL COMPLETION DATA:

- (1) diameter (inches) 2"
- (2) total depth (feet) 40'
- (3) static water level (feet) 19' below top of ground.
- (4) casing 2" PVC, 35' (material) (depth)
 2" (size) if telescope see back.
- (5) screen 5' 35' (length) (depth to top)
 2" PVC, 008 (size) (material)
- (6) pump 1/2 HP, 5 (yield gpm)
 110 AC (type power)
- (7) electric log No (yes or no)

CODED

(organization running log)


(8) how well bottom plugged

DRILLERS REMARKS:

RECEIVED
 JUN 2 11 1974
 MISS. DD. OF WATER

If well telescopes please sketch and show depths.

GROUND LEVEL

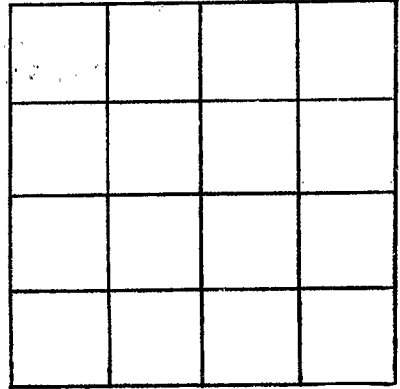

SECTION _____

Please indicate well location X.

ADDITIONAL INFORMATION

If more than one screen, show locations of each on sketch.