

WAYNE

1974

6-4-74

MISSISSIPPI
 BOARD OF WATER COMMISSIONERS
 416 North State Street
 Jackson, Mississippi 39201

CODED

WATER WELL DRILLERS LOG

June 4, 1974
date well completed

McILWAIN WATER WELL SERVICE

WAYNE

RT. 2, BOX 37

county well located

WAYNESBORO, MISS. 39367

LANDOWNER:

Billy McIlwain

Rt 2 Waynesboro, Miss
(mailing address)

description of formations encountered

Red Clay

from

to

0

6

White Chalk

6

10

Fine Sand

10

14

Chalk

14

20

Fine Sand, Home
Clay

20

30

Med Sand

30

40

Coarse Sand

40

50

WELL LOCATION:

sec. 2 T 8 N R 6 E
6 miles E of WBORO
(distance) (direction) (nearest town)

WELL PURPOSE: HOME
(home, irrigation, municipal, industrial)

WELL COMPLETION DATA:

(1) diameter (inches) 2"
(2) total depth (feet) 50'
(3) static water level (feet) 31' below top of ground.

(4) casing PVC 40'
(material) (depth)
2" (size) If telescope see back.

(5) screen 10' 40'
(length) (depth to top)
2" PVC .008
(size) (material)

(6) pump 1/2 6
(HP) (yield gpm)
110 AC
(type power)

(7) electric log (yes or no)

(organization running log)

(8) how well bottom plugged


DRILLERS REMARKS:

CODED

WAYNESBORO MISSISSIPPI
JUN 10 1974
MISSISSIPPI BOARD OF WATER COMMISSIONERS

If well telescopes please sketch and show depths.

GROUND LEVEL

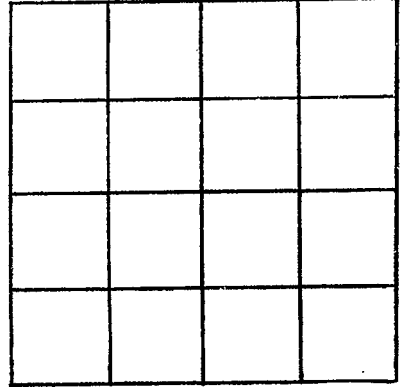

SECTION _____

Please indicate well location X.

ADDITIONAL INFORMATION

If more than one screen, show locations of each on sketch.