

**MISSISSIPPI  
BOARD OF WATER COMMISSIONERS**  
416 North State Street  
Jackson, Mississippi 39201

**WATER WELL DRILLERS LOG**

**CODED**

**WAYNE**

**P201**

**9-9-74**

date well completed

firm name

county well located

LANDOWNER: Chester

description of formations encountered

from

to

Cooper

weathered sand

0

33

Rt 4 Waynesboro  
(mailing address)

shells

33

75

WELL LOCATION:

ss sand

75

90

sec 21 T 80 N R 6 E

shells

90

111

3 miles SE of Waynesboro  
(distance) (direction) (nearest town)

shells some sand

111

120

WELL PURPOSE: home

blue chalk

120

150

(home, irrigation, municipal, industrial)

in milk strainer

150

192

WELL COMPLETION DATA:

Wicksburg

262

290

(1) diameter (inches) 2"

126' 1 1/2" diameter

(2) total depth (feet) 290'

00

0

(3) static water level (feet) 115 (below above top of ground)

(4) casing steel, 262'  
(material) (depth)

2"  
(size) if telescope see back.

(5) screen none used  
(length) (depth to top)

(size) (material)

(6) pump 2 7 1/2  
(HP) (yield gpm)

elec.  
(type power)

(7) electric log no  
(yes or no)

(organization running log)

(8) how well bottom plugged open

DRILLERS REMARKS:


**REGISTERED  
INDEPENDENT**

SEP 11 1974

MISS. BD. OF WATER COMM.

If well telescopes please sketch and show depths.

GROUND LEVEL

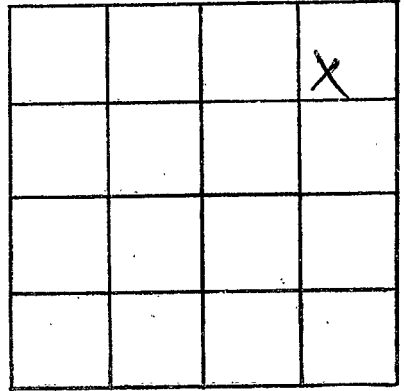

SECTION 21

Please indicate well location X.

ADDITIONAL INFORMATION

If more than one screen,  
show locations of each on sketch.