

**MISSISSIPPI
BOARD OF WATER COMMISSIONERS**
416 North State Street
Jackson, Mississippi 39201

CODED

WATER WELL DRILLERS LOG

WAYNE
0202
10/10/74
02110

date well completed

1974 *Bohrer Drilling & Log*

firm name

Wayne

county well located

LANDOWNER: *Earnest Felts*
at 4 Waynesboro
Miss.
(mailing address)

WELL LOCATION:
sec. *27* T. *2* N. R. *6* E. W. *3*
3 miles *SE* of *Waynesboro*
(distance) (direction) (nearest town)

WELL PURPOSE: *None*
(home, irrigation, municipal, industrial)

WELL COMPLETION DATA:

(1) diameter (inches) *2*

(2) total depth (feet) *57'*

(3) static water level (feet) *45'* (below/above top of ground)

(4) casing *P.V.C.* *52'*
(material) (depth)
2' If telescope see back.
(size)

(5) screen *5'* *52'*
(length) (depth to top)
1 1/4" *6 slot SS.*
(size) (material)

(6) pump *1* *7 1/2*
(HP) (yield gpm)
elec.
(type power)

(7) electric log *no*
(yes or no)

(organization running log)

description of formations encountered	from	to
<i>sand</i>	<i>0</i>	<i>4</i>
<i>white chalk</i>	<i>4</i>	<i>15</i>
<i>sand</i>	<i>15</i>	<i>40</i>
<i>sand & chalk</i>	<i>40</i>	<i>45</i>
<i>sand</i>	<i>45</i>	<i>57</i>
<i>stagnant on chalk</i>		
<i>5' CODED 6 slot SS</i>		
<i>renewed in end of cas.</i>		
<i>with back wash valve</i>		
<i>on end and shell</i>		
<i>log above</i>		
<i>50' 1" P.V.C. drop pipe</i>		


(8) show well bottom plugged *back wash valve*

DRILLERS REMARKS:

DRILLER'S SIGNATURE
[Signature]
OCT 22 1974

If well telescopes please sketch and show depths.

GROUND LEVEL

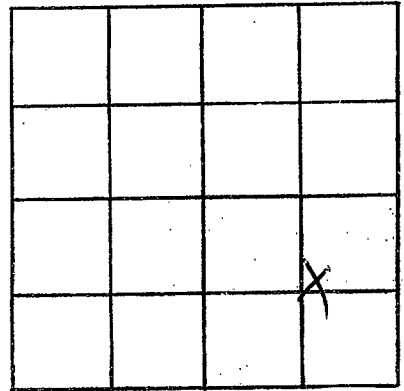

SECTION 27

Please indicate well location X.

ADDITIONAL INFORMATION

If more than one screen,
show locations of each on sketch.