

WAYNE  
 D 203  
 1-30-75

MISSISSIPPI  
 BOARD OF WATER COMMISSIONERS  
 416 North State Street  
 Jackson, Mississippi 39201

CODED

WATER WELL DRILLERS LOG  
 McILWAIN WATER WELL SERVICE

JAN 30 - 75  
 date well completed


PT. 2, BOX 37

WAYNE

WAYNESBORO, MISS. 39367

county well located

LANDOWNER:	description of formations encountered	from	to
ROBERT A. DAVIS			
RT 4 WAYNESBORO, MISS (mailing address)	Red sand	8	29
WELL LOCATION:	Clay & Sand streaks	29	55
sec. 5 T. 8 N. R. 6 E. W. 2	Clay	55	60
(distance) miles (direction) of W'boro (nearest town)	Sand	60	69
WELL PURPOSE: HOME (home, irrigation, municipal, industrial)			
WELL COMPLETION DATA:			
(1) diameter (inches) 2"			
(2) total depth (feet) 69'			
(3) static water level (feet) 27' below top of ground.			
(4) casing PVC 64' (material) (depth)			
2" (size) If telescope see back.			
(5) screen 5' 64' (length) (depth to top)			
2" PVC 008 (size) (material)			
(6) pump 1 9 (HP) (yield gpm)			
110 AC (type power)			
(7) electric log NO (yes or no)			
(organization running log)			
(8) how well bottom plugged			
DRILLERS REMARKS:			

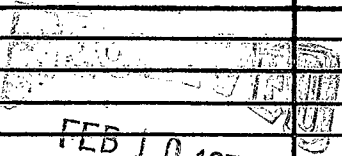


FEB 10 1975

MISS. RD. OF WATER COMMISSIONERS

If well telescopes please  
sketch and show depths.

GROUND LEVEL

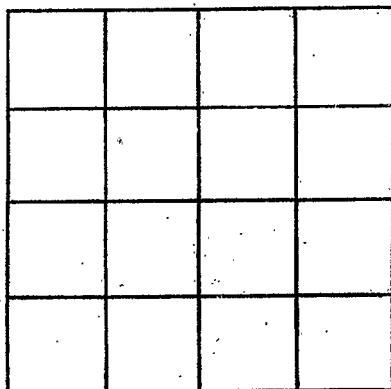

SECTION \_\_\_\_\_

Please indicate well location X.

ADDITIONAL INFORMATION

If more than one screen,  
show locations of each on sketch.