

**WAYNE**  
 0-204-205  
 4-2-75

MISSISSIPPI  
 BOARD OF WATER COMMISSIONERS  
 416 North State Street  
 Jackson, Mississippi 39201

CODED

WATER WELL DRILLERS LOG


Apr. 2, 1975 19 McILWAIN WATER WELL SERVICE WAYNE  
 date well completed RT. # BOX 37 county well located  
 WAYNESBORO, MISS. 39367

LANDOWNER:  
 George Robinson  
 Waynesboro, Miss.  
 (mailing address)

WELL LOCATION:  
 sec. 21 T. 8 N R. 6 E  
 3 miles SE of W'BORO  
 (distance) (direction) (nearest town)

WELL PURPOSE: HOME  
 (home, irrigation, municipal, industrial)


- WELL COMPLETION DATA:
- (1) diameter (inches) 2"
  - (2) total depth (feet) 65'
  - (3) static water level (feet) 45' below top of ground.
  - (4) casing PVC, 60' (material), (depth)  
 2" (size) if telescope see back.
  - (5) screen 5', 60' (length), (depth to top)  
 2" PVC, 008 (size), (material)
  - (6) pump 3/4, 8 (HP), (yield gpm)  
 220 AC (type power)
  - (7) electric log NO (yes or no)  
 (organization running log)
  - (8) how well bottom plugged

description of formations encountered	from	to
Red Clay	0	5
Red sand	5	23
Some Clay + sand	23	32
Clay	32	47
Fine sand	47	56
Med. Sand	56	65
CODED		
		
APR 14 1975		
MISS. BD. OF WATER COMMISSIONERS		

DRILLERS REMARKS:

If well telescopes please sketch and show depths.

GROUND LEVEL

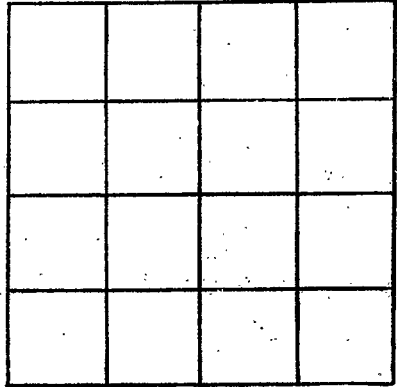

SECTION \_\_\_\_\_

Please indicate well location X.

ADDITIONAL INFORMATION

If more than one screen, show locations of each on sketch.