

CODED

MISSISSIPPI
BOARD OF WATER COMMISSIONERS
416 North State Street
Jackson, Mississippi 39201

Wayne
D 206
5-31-75

WATER WELL DRILLERS LOG
McILWAIN WATER WELL SERVICE

Wayne

May 31, 1975
date well completed

RT. 2 BOX 37

WAYNESBORO, MISS. 39367

county well located

LANDOWNER:

description of formations encountered

from

to

Mr. Rodney Thames
Rt 4 Waynesboro, Miss.
(mailing address)

Red Clay	0	10
Red sand	10	25
White clay	25	47
Sand	47	67

WELL LOCATION:

sec. 35 T 8 N R 6 E 13P
6 miles SE of Waynesboro
(distance) (direction) (nearest town)

WELL PURPOSE: HOME
(home, irrigation, municipal, industrial)

WELL COMPLETION DATA:

- (1) diameter (inches) 2"
- (2) total depth (feet) 67'
- (3) static water level (feet) 46' below top of ground
- (4) casing PVC 62' (material) (depth)
2" (size) If telescope see back.
- (5) screen 5' 62' (length) (depth to top)
2" PVC .008 slot (size) (material)
- (6) pump 1 10 (HP) (yield gpm)
220 AC (type power)
- (7) electric log NO (yes or no)

(organization running log)

(8) how well bottom plugged


DRILLERS REMARKS:

McILWAIN
10
MAY 30 1975

MISS. Bd. OF WATER COMMISSIONERS

If well telescopes please sketch and show depths.

GROUND LEVEL

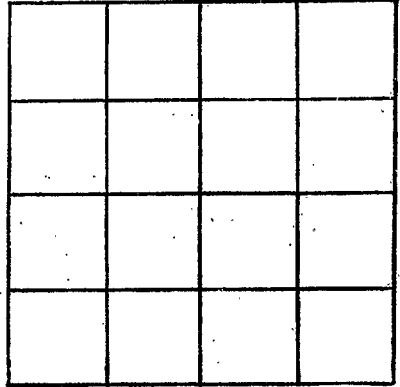

SECTION _____

Please indicate well location X.

ADDITIONAL INFORMATION

If more than one screen, show locations of each on sketch.