

Wayne
 0207
 6-12-75

MISSISSIPPI
 BOARD OF WATER COMMISSIONERS
 416 North State Street
 Jackson, Mississippi 39201

CODED

WATER WELL DRILLERS LOG

JUNE 12, 1975 19 McILWAIN WATER WELL SERVICE Wayne
 date well completed RT-firm name BOX 31 county well located
 WAYNESBORO, MISS. 39367

LANDOWNER:	description of formations encountered	from	to
MR. W.D. HUMPHREY			
Rt 4 WAYNESBORO, MISS. (mailing address)	Red sand	12	38
WELL LOCATION: sec. <u>35</u> T <u>8</u> N R <u>6</u> W 13P 7 miles <u>SE</u> of <u>W'BORO</u> (distance) (direction) (nearest town)	White clay	38	60
WELL PURPOSE: <u>HOME</u> (home, irrigation, municipal, industrial)	Sand	60	68
WELL COMPLETION DATA: (1) diameter (inches) <u>2"</u>	Clay	68	74
(2) total depth (feet) <u>108'</u>	Fine sand	74	90
(3) static water level (feet) <u>83'</u> below top of ground.	Coarse sand	90	108
(4) casing <u>2"</u> (material), <u>103'</u> (depth) <u>2"</u> If telescope see back. (size)			
(5) screen <u>5'</u> (length), <u>103'</u> (depth to top) <u>2"</u> (size) (material)			
(6) pump <u>1</u> (HP), <u>6</u> (yield gpm) <u>220 AC</u> (type power)			
(7) electric log <u>no.</u> (yes or no) (organization running log)			
(8) how well bottom plugged _____			
DRILLERS REMARKS:			


RECEIVED
 DECEMBER 11
 1975

JUL 24 1975

MISS. Bd. OF WATER COMMISSIONERS

If well telescopes please sketch and show depths.

GROUND LEVEL

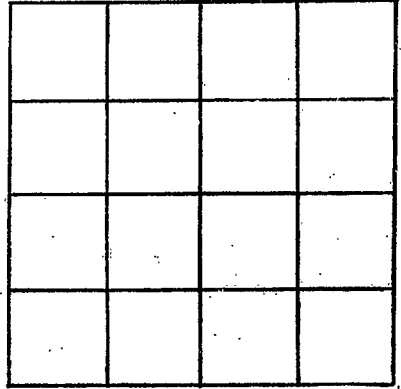

SECTION _____

Please indicate well location X.

ADDITIONAL INFORMATION

If more than one screen, show locations of each on sketch.