

Wayne  
 028  
 6-17-75

CODED

MISSISSIPPI  
 BOARD OF WATER COMMISSIONERS  
 416 North State Street  
 Jackson, Mississippi 39201

WATER WELL DRILLERS LOG


JUNE 17, 1975 19 McILWAIN WATER WELL SERVICE Wayne  
 date well completed RT. #2 BOX 31 county well located  
 WAYNESBORO, MISS. 39367

LANDOWNER:	description of formations encountered	from	to
ALEX McILWAIN JR.	Red Sandy Clay	0	10
Rt 2 WAYNESBORO, MISS. (mailing address)	Clay	10	12
WELL LOCATION:	Red Sand	10	25
sec. 1 T. 8 N R. 6 E 13 P 6 miles E of W'BORO (distance) (direction) (nearest town)	Clay + Sand	25	30
WELL PURPOSE: HOME (home, irrigation, municipal, industrial)	Coarse sand	30	42
WELL COMPLETION DATA:	Yellow Clay	42	47
(1) diameter (inches) 2"	Blue Clay	47	80
(2) total depth (feet) 195'	Rock + limy Clay	80	100
(3) static water level (feet) 117' below top of ground.	Blue Clay	100	155
(4) casing PVC, 158' (material) (depth) 2" (size) If telescope see back.	Honeycomb Rock	155	195
(5) screen NONE (length) (depth to top)			
(6) pump 1/2 (HP) 5 (yield gpm)			
220 AC (type power)			
(7) electric log YES (yes or no)			
(organization running log)			
(8) how well bottom plugged			
DRILLERS REMARKS:			

RECEIVED  
 JUL 24 1975  
 MISS. Bd. OF WATER COM.

If well telescopes please sketch and show depths.

GROUND LEVEL

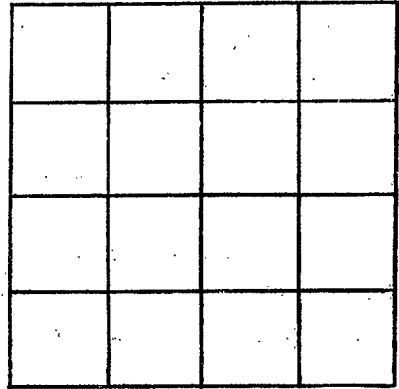

SECTION \_\_\_\_\_

Please indicate well location X.

ADDITIONAL INFORMATION

If more than one screen, show locations of each on sketch.