

CODED

Wayne  
① 209  
7-11-75

MISSISSIPPI  
BOARD OF WATER COMMISSIONERS  
416 North State Street  
Jackson, Mississippi 39201

WATER WELL DRILLERS LOG

McILWAIN WATER WELL SERVICE

Wayne

July 11, 1975

date well completed

RT. 1 BOX 57

WAYNESBORO, MISS. 39367

county well located


LANDOWNER:	description of fomations encountered	from	to
A. B. STURDIVANT	Sandy Clay	0	5
Rt 4 WAYNESBORO, Miss. (mailing address)	Coarse Sand	5	10
WELL LOCATION: sec. 36 T 8 N R 6 E 13 P	Clay	10	35
7 miles SE of W'BORO (distance) (direction) (nearest town)	Sand	35	44
WELL PURPOSE: HOME (home, irrigation, municipal, industrial)	Clay	44	53
WELL COMPLETION DATA:	Fine Sand	53	55
(1) diameter (inches) 2"	Clay	55	60
(2) total depth (feet) 80'	Sand	60	80
(3) static water level (feet) 40' below top of ground.			
(4) casing PVC, 75' (material) (depth) 2" (size) if telescope see back.			
(5) screen 5' 75' (length) (depth to top) 2" PVC-008 Slot (size) (material)			
(6) pump 1 12 (HP) (yield gpm) 110 AC (type power)			
(7) electric log NO (yes or no) (organization running log)			
(8) how well bottom plugged			
DRILLERS REMARKS:			

RECEIVED  
MAY 24 1975

MISS. BD. OF WATER COMMISSIONERS

If well telescopes please sketch and show depths.

GROUND LEVEL

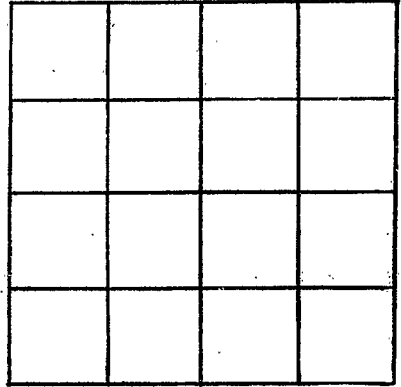

SECTION \_\_\_\_\_

Please indicate well location X.

ADDITIONAL INFORMATION

If more than one screen, show locations of each on sketch.