

C. P. CLARK

WATER WELL DRILLING

ROUTE 2

MISSISSIPPI  
BOARD OF WATER COMMISSIONERS, MISS. 39440  
416 North State Street  
Jackson, Mississippi 39201

CODED

Wayne  
D 210  
7-3-75

WATER WELL DRILLERS LOG

7/3 1975  
date well completed

C.P. Clark  
firm name

Wayne  
county well located

LANDOWNER: Foyleaf Forest Products  
Waynesboro, Miss  
(mailing address)

description of formations encountered

from to

Play	0	11
Sand	11	19
Blue Clay	19	42
Clay with Shreds	42	72
Clay	72	95
Sand (Fine)	95	126
Clay	126	131

WELL LOCATION:

sec. 18 T. 4N. R. 6E. 13P  
S. W  
1/4 miles SE of Waynesboro  
(distance) (direction) (nearest town)

WELL PURPOSE: Drill  
(home, irrigation, municipal, industrial)

WELL COMPLETION DATA:


- (1) diameter (inches) 4
- (2) total depth (feet) 131
- (3) static water level (feet) 30 below top of ground.
- (4) casing Black Iron 95  
(material) (depth)
- (size) If telescope see back.
- (5) screen 31 95  
(length) (depth to top)
- 2 1/2 Galv. S.S. 006  
(size) (material)
- (6) pump 5 70  
(HP) (yield gpm)
- 4400  
(type power)
- (7) electric log NO  
(yes or no)

(organization running log)

(8) how well bottom plugged B.W.V.

DRILLERS REMARKS:


Set Blank  
2 1/2" dia pipe 126 to 131

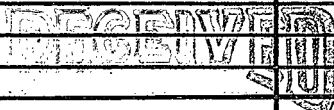

AUG 18 1975

If well telescopes please  
sketch and show depths.

GROUND LEVEL

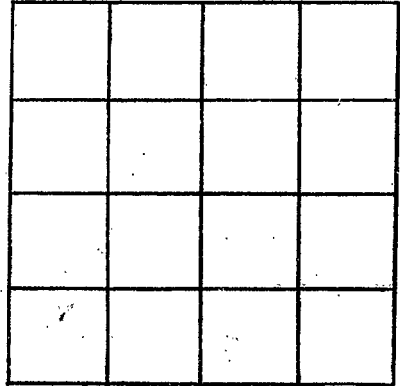

SECTION \_\_\_\_\_

Please indicate well location X.

ADDITIONAL INFORMATION

If more than one screen,  
show locations of each on sketch.