

CODED

Wayne
Ø 211
9-5-75

MISSISSIPPI
BOARD OF WATER COMMISSIONERS
416 North State Street
Jackson, Mississippi 39201

WATER WELL DRILLERS LOG

Sept 5, 1975 19 McILWAIN WATER WELL SERVICE WAYNE
date well completed RT. firm name BOX 31 county well located
WAYNESBORO, MISS. 39367

LANDOWNER:
RICHARD POUNDS
Waynesboro, Miss.
(mailing address)

description of formations encountered	from	to
Sandy Clay	0	4
Hard Clay	4	8
Coarse Sand		
Some gravel	8	15
Coarse Sand	15	25
Blue Clay	25	30
Rock and limy clay	30	45
Blue Clay	45	62
Rock + Clay	62	75
Brown Clay	75	95
Med. Sand	95	105

WELL LOCATION:
sec. 18 T 8 N R. 6 E 13P
1/2 miles SE of Waynesboro
(distance) (direction) (nearest town)

WELL PURPOSE: Home
(home, irrigation, municipal, industrial)

- WELL COMPLETION DATA:
- (1) diameter (inches) 2"
 - (2) total depth (feet) 105'
 - (3) static water level (feet) 40' below top of ground.
 - (4) casing PVC 100' (material) (depth)
2" (size) if telescope see back.
 - (5) screen 5' 100' (length) (depth to top)
2" (size) PVC D10 (material)
 - (6) pump 1 (HP) 10 (yield gpm)
220 AC (type power)
 - (7) electric log No (yes or no)

(organization running log)


(8) how well bottom plugged

DRILLERS REMARKS:

SEP 15 1975

If well telescopes please sketch and show depths.

GROUND LEVEL

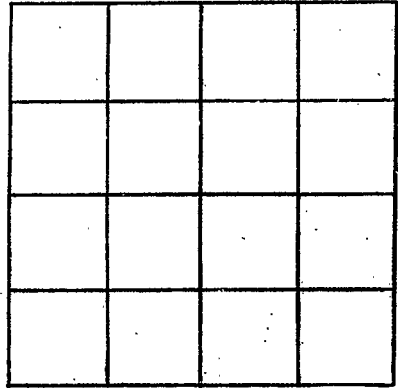

SECTION _____

Please indicate well location X.

ADDITIONAL INFORMATION

If more than one screen, show locations of each on sketch.