

Wayne
 D 2012
 10-10-75

MISSISSIPPI
 BOARD OF WATER COMMISSIONERS
 416 North State Street
 Jackson, Mississippi 39201

WATER WELL DRILLERS LOG

Oct 10, 75 1975 date well completed
 McILWAIN WATER WELL SERVICE Wayne
 Rt 4, Box 37 Waynesboro, Miss. 39367 county well located


LANDOWNER:	description of formations encountered	from	to
T. L. MORGAN	Red Clay	0	10
Rt 4 WAYNESBORO (mailing address)	Red Sand	10	15
WELL LOCATION: sec. 17 T. 8 N R. 6 E 1 miles E of W. BORO (distance) (direction) (nearest town)	Mixed Clay	15	23
	Sand	23	30
WELL PURPOSE: HOME (home, irrigation, municipal, industrial)	Sand + Clay streaks	30	75
WELL COMPLETION DATA:	Sand	75	90
(1) diameter (inches) 2"			
(2) total depth (feet) 90'			
(3) static water level (feet) 64' below top of ground.			
(4) casing PVC 85' (material) (depth) 2" (size) If telescope see back.			
(5) screen 5' 85' (length) (depth to top) 2" (size) PVC (material)			
(6) pump 1 (HP) 8 (yield gpm) 220 AC (type power)			
(7) electric log no (yes or no)			
(organization running log)			
(8) how well bottom plugged			

SEPT 22 1975
 MISS. Bd. OF WATER COMMISSIONERS

DRILLERS REMARKS:

If well telescopes please sketch and show depths.

GROUND LEVEL

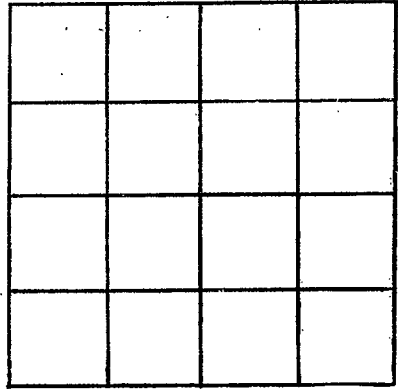

SECTION _____

Please indicate well location X.

ADDITIONAL INFORMATION

A series of horizontal lines providing space for additional information or notes.

If more than one screen, show locations of each on sketch.