

Wayne
 Ø 213
 10-9-75

MISSISSIPPI
 BOARD OF WATER COMMISSIONERS
 416 North State Street
 Jackson, Mississippi 39201

CODED

WATER WELL DRILLERS LOG

McILWAIN WATER WELL SERVICE

Wayne

Oct 9, 75 19
 date well completed

RI firm name BOX 37
 WAYNESBORO MISS 39367

county well located


LANDOWNER:
 JERRY M^{rs} RAE
 Route 4 WAYNESBORO
 (mailing address)

description of formations encountered	from	to
Red clay	0	8
Mixed clay	8	17
Sand	17	42
clay	42	46
Sand + clay	46	73
Sand	73	79

WELL LOCATION:
 sec. 12 T 8 N R. 6 E
 6 miles E of W'BORO
 (distance) (direction) (nearest town)

WELL PURPOSE: HOME
 (home, irrigation, municipal, industrial)

- WELL COMPLETION DATA:
- (1) diameter (inches) 2"
 - (2) total depth (feet) 79
 - (3) static water level (feet) 42' below top of ground.
 - (4) casing PVC 74' (material) (depth)
 2" (size) if telescope see back.
 - (5) screen 5' 74' (length) (depth to top)
 2" (size) PVC (material)
 - (6) pump 1/2 (HP) 7 (yield gpm)
 110 AC (type power)
 - (7) electric log no (yes or no)
 - (organization running log)
 - (8) how well bottom plugged

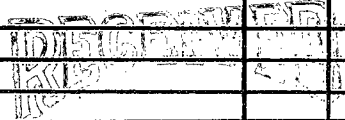

OCT 23 1975

DRILLERS REMARKS:

