

WAYNE
 Ø 216
 6-8-79

MISSISSIPPI
 BOARD OF WATER COMMISSIONERS
 416 North State Street
 Jackson, Mississippi 39201

CODED

WATER WELL DRILLERS LOG

June 8 1979 Porter Drilling Wayne
 date well completed firm name county well located

LANDOWNER: Richard W. Brown
of Miss.
Waynesboro Miss.
 (mailing address)

description of formations encountered	from	to
Clay	0	18
sand	18	25
Clay	25	47
rock strata	47	55
Clay	55	73
rock strata	73	89
Clay	89	103
partly clay	103	112
fine sand	112	131
Clay	131	150

WELL LOCATION:
 sec. 19 N R. 6 E
1/2 miles S of Waynesboro
 (distance) (direction) (nearest town)

WELL PURPOSE: industrial
 (home, irrigation, municipal, industrial)

- WELL COMPLETION DATA:
- (1) diameter (inches) 4"
 - (2) total depth (feet) 132
 - (3) static water level (feet) 45" below top of ground.
 - (4) casing PVC 106'
 (material) (depth)
4" (size) If telescope see back.
 - (5) screen 26' 106'
 (length) (depth to top)
2" brist 3.5
 (size) (material)
 - (6) pump 5 70
 (HP) (yield gpm)
elec.
 (type power)
 - (7) electric log not
 (yes or no)
- (organization running log)

(8) how well bottom plugged 2' back wash stone

100' 2' gate drop

pipe

CODED

Miss. Board of Water Comm.


JUN 18 1979

DRILLERS REMARKS:

RECEIVED

If well telescopes please sketch and show depths.

GROUND LEVEL

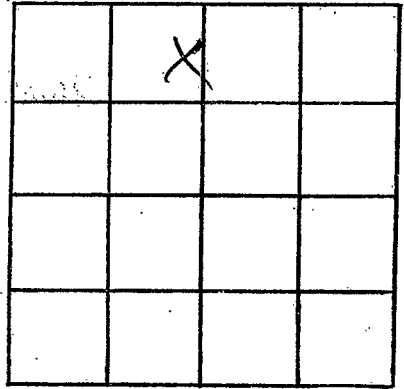

SECTION 19

Please indicate well location X.

ADDITIONAL INFORMATION

If more than one screen,
show locations of each on sketch.