

MISSISSIPPI DEPARTMENT OF NATURAL RESOURCES

Bureau of Land and Water Resources

Southport Mall

P.O. Box 10631

Jackson, Mississippi 39209

WATER WELL DRILLERS LOG

Q 223
Wayne

April 18 1985 Port Drillers, Inc. Wayne
 date well completed firm name county well located

LANDOWNER: Beck Motel
Haynesboro, Ms.
 (mailing address)

description of formations encountered from to
sand 0 22
shale in sand

WELL LOCATION:
 sec 18 T 8 N R 6 E
1/2 miles SE of Haynesboro
 (distance) (direction) (nearest town)

WELL PURPOSE: water
 (home, irrigation, municipal, industrial)

- WELL COMPLETION DATA:
- (1) diameter (inches) 1 1/4
 - (2) total depth (feet) 22
 - (3) static water level (feet) 6 (below above top of ground)
 - (4) casing P.V.C. 17' 11" 80
 (material) (depth)
1 1/4 (size) If telescope see back.
 - (5) screen 5' 17'
 (length) (depth to top)
1 1/4 galv S.S.
 (size) (material)
 - (6) pump 3/4 10
 (HP) (yield gpm)
elec.
 (type power)
 - (7) electric log no
 (yes or no)
 (organization running log)
 - (8) how well bottom plugged plugged


RECEIVED
 MAY - 6 1985

DRILLERS REMARKS:

Department of Natural Resources
 Bureau of Land & Water Resources

If well telescopes please sketch and show depths.

GROUND LEVEL

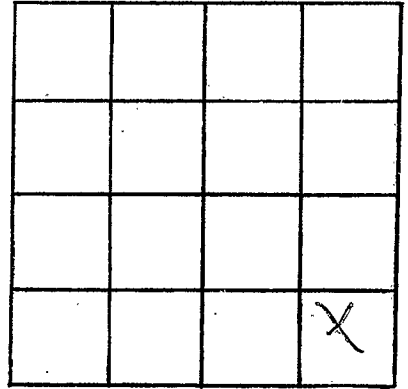

SECTION 18

Please indicate well location X.

ADDITIONAL INFORMATION

If more than one screen,
show locations of each on sketch.