

MISSISSIPPI DEPARTMENT OF NATURAL RESOURCES

Bureau of Land and Water Resources

Southport Mall

P.O. Box 10631

Jackson, Mississippi 39209

WATER WELL DRILLERS LOG

CODED

WAYNE  
 #225  
 4-7-86

4-7 date well completed

1986 Roy G. West Dalg firm name

Wayne county well located

LANDOWNER:  
 CHARLES H. Field  
 Waynesboro MS  
 (mailing address)

description of formations encountered

from to

CLAY	0	3
SAND	3	32
CLAY	32	93
Limestone CLAY str	93	160

WELL LOCATION:

sec. 10 T. 8 N. R. 6 E. S. W.  
 3 miles E of Waynesboro  
 (distance) (direction) (nearest town)

WELL PURPOSE: HOME  
 (home, irrigation, municipal, industrial)

WELL COMPLETION DATA:

- (1) diameter (inches) 2"
- (2) total depth (feet) 160'
- (3) static water level (feet) 91' below above top of ground.
- (4) casing PVC, 133' (material) (depth)  
 (size) If telescope see back.
- (5) screen OPEN END (length) (depth to top)  
 (size) (material)
- (6) pump 1 1/2 (HP) 8 (yield gpm)  
 REA (type power)
- (7) electric log NO (yes or no)  
 (organization running log)
- (8) how well bottom plugged OPEN


RECEIVED  
 MAY 6 1986

DRILLERS REMARKS:

Department of Natural Resources  
 Bureau of Land and Water Resources

If well telescopes please sketch and show depths.

GROUND LEVEL

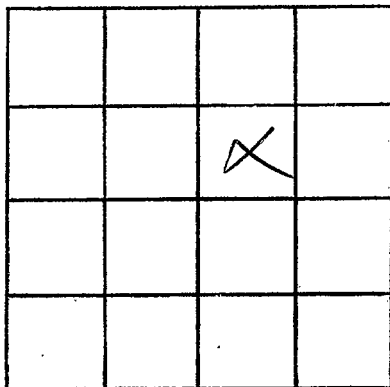

SECTION 16

Please indicate well location X.

ADDITIONAL INFORMATION

If more than one screen, show locations of each on sketch.