

MISSISSIPPI DEPARTMENT OF NATURAL RESOURCES

Bureau of Land and Water Resources

Southport Mall

P.O. Box 10631

Jackson, Mississippi 39209

WATER WELL DRILLERS LOG

WAYNE
 227
 CODSD

1-27-95

date well completed

19

Morphis Brothers

firm name

Wayne

county well located


LANDOWNER: Robertson Onshore
 860 East River Place
 Suite 206
 Jackson, Miss 39202
 (mailing address)

WELL LOCATION:
 sec. 1 T. 8 (N) R. 6 E
 S W
 7 miles SE of Lumberton
 (distance) (direction) (nearest town)

WELL PURPOSE: Rig Supply
 (home, irrigation, municipal, industrial)

- WELL COMPLETION DATA:
- (1) diameter (inches) 4
 - (2) total depth (feet) 500
 - (3) static water level (feet) 80 below above top of ground.
 - (4) casing PVC, 440 (material) (depth)
 4 (size) if telescope see back.
 - (5) screen 60 (length) (depth to top)
 4 PVC (size) (material)
 - (6) pump (HP) (yield gpm)
 Elec (type power)
 - (7) electric log No (yes or no)
 (organization running log)
 - (8) how well bottom plugged BWV

description of formations encountered	from	to
Med Clay	0	10
Blue clay w/rock	10	40
Dark gray clay	40	84
Limestone; soft white clay	84	137
Silty gray clay	137	220
Silty gray clay w/rock stks	220	240
Gray clay	240	280
Gray clay w/rock stks	280	302
Fine gray sand; gray clay	302	320
Rocky clay w/sd stks	320	360
Gray silty clay	360	380
Brown clay w/sd stks & lig	380	420
Med Sand w/c.b.	420	440
Fine; med Sand w/lig; clay	440	460
Fine sand; gray clay	460	500
1866'S E 1050' W OF NE/COR		

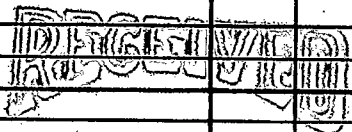


FEB 27 1995

Dept. of Environmental Quality
 Bureau of Land & Water Resources

DRILLERS REMARKS:

If well telescopes please sketch and show depths.

GROUND LEVEL

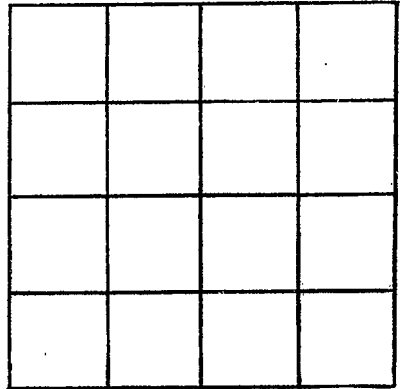

SECTION _____

Please indicate well location X.

ADDITIONAL INFORMATION

A series of horizontal lines for providing additional information, located below the 'ADDITIONAL INFORMATION' header.

If more than one screen, show locations of each on sketch.