

MISSISSIPPI DEPARTMENT OF ENVIRONMENTAL QUALITY
Bureau of Land and Water Resources

P. O. Box 10631
Jackson, MS 39289-0631
WATER WELL DRILLERS LOG

COUNTY WELL LOCATED Wayne	
WELL NUMBER # 1	CODED 228
DATE WELL COMPLETED 12-18-96	

PERMIT NUMBER
NAME OF DRILLING FIRM Galner Drilling Service Inc.

NAME & MAILING ADDRESS OF LANDOWNER Anadarko Petroleum P.O. Box 1330
--

WELL LOCATION Waynesboro	SEC 1	TOWNSHIP 8 N	RANGE 6 E
------------------------------------	-----------------	------------------------	---------------------

DISTANCE 6.6 Miles	DIRECTION East of	NEAREST TOWN 84445
------------------------------	-----------------------------	------------------------------

OTHER LANDMARK Waynesboro
WELL PURPOSE: Home, Irrigation, Municipal, Industrial, Fish Pond, etc. Oilfield Rig Supply

WELL DATA

Well Depth 320'	Casing Diameter (In.) 4	Casing Length (Ft.) 300'
Type of Casing PVC	Hole Depth 320'	Depth to Static Water Level 39'

TYPE OF COMPLETION: (Circle One or More):
 Gravel Packed, Underreamed, Telescoped,
 Natural Development, Open Hole, Other
 (Describe)

Top of Lap Pipe or Reduction in Casing

FEET	IF TELESCOPED OR MORE THAN ONE SCREEN: USE BACK PAGE
------	--

SCREEN DATA

Diameter - Inches 4	Length - Feet 20'	Slot Size - Inches .010
Screen Type PVC	Depth to Bottom - Feet 320	

DESCRIPTION OF FORMATIONS ENCOUNTERED	FROM	TO
Clay	0	15
Rock & Clay	15	300
Sand	300	320
Rock	320	-

PUMP DATA

PUMP TYPE (Circle One):
 Submersible, Turbine, Jet, Flowing Well,
 Other (Describe) _____

POWER TYPE (Circle One):
 Electric, Tractor, Diesel, Gasoline, Butane,
 Other (Describe) _____ H/P **7/2**

Pump Capacity (GPM) 80	No. of Stages	Setting Depth FT.
----------------------------------	---------------	-----------------------------

PUMP TEST

Well yielded **Artificial 37** GPM with
 a drawdown of **NO elect to** ft.
 after **Test with Priming** hours of pumping

LOG DATA


TYPE OF LOG RUN (Circle One):
 No Log Run, Electric, Gamma Ray, Density, Sonic, Neutron,
 Other (Describe) _____

Name of Organization Running Log

GEOLOGIC DATA (Office Use Only)

Surface Elev.	Geologic Unit	Unit Thickness	Depth to Top
Subs. SWL	Date	Analysis	Aquifer Test

Driller's Remarks
sand between
Two Rocks
330'S 1700'E of NW/Cor

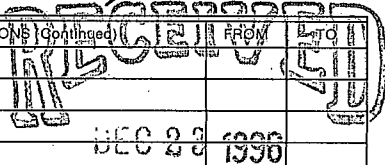


Dept. of Environmental Quality
Office of Land & Water Resources

IF MORE SPACE IS NEEDED, USE BACK

NO. 1 U.S.A. 1-3

If well telescopes please
sketch and show depths.

GROUND LEVEL

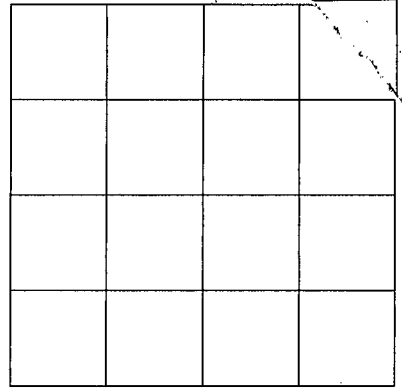

SECTION _____

Please indicate well location X.

ADDITIONAL INFORMATION

If more than one screen,
show location of each on sketch.