

MISSISSIPPI DEPARTMENT OF ENVIRONMENTAL QUALITY

Office of Land and Water Resources

P. O. Box 10631
Jackson, MS 39289-0631
WATER WELL DRILLERS LOG

COUNTY WELL LOCATED
Wayne

WELL NUMBER 0-229 CODED

DATE WELL COMPLETED
11-26-02

PERMIT NUMBER

NAME OF DRILLING FIRM
Roy V. West Drilling

NAME & MAILING ADDRESS OF LANDOWNER
Paula Johnson
Waynesboro MS

Latitude:
Longitude:

WELL LOCATION: SEC 7 TOWNSHIP 8 RANGE 6 ^N _E

DISTANCE DIRECTION NEAREST TOWN

OTHER LANDMARK
Inside city of Waynesboro
In Timberidge Estates

WELL PURPOSE: Home, Irrigation, Municipal, Industrial, Fish Pond, etc.

PUMP DATA

PUMP TYPE (Circle One):
Submersible Turbine, Jet, Flowing Well,
Other (Describe) _____

POWER TYPE (Circle One):
Electric Tractor, Diesel, Gasoline, Butane,
Other (Describe) _____ H/P 1

DESCRIPTION OF FORMATIONS ENCOUNTERED	FROM	TO
Top soil	0	1
SANDY RED CLAY	1	13
SAND	13	66
CLAY	66	68
SAND	68	80

WELL DATA

Well Depth <u>80</u>	Casing Diameter (In.) <u>4</u>	Casing Length (Ft.) <u>70</u>
Type of Casing <u>PVC</u>	Hole Depth <u>80</u>	Depth to Static Water Level <u>45</u>

TYPE OF COMPLETION: (Circle One or More):
Natural Development, Gravel Packed, Underreamed, Telescoped, Open Hole, Other

WELL GROUTED TO A DEPTH OF 10 FEET
Type Grout (circle one): Cement, Bentonite, or Mix

SCREEN DATA

Diameter - Inches <u>4</u>	Length - Feet <u>10</u>	Slot Size - Inches <u>.010</u>
Screen Type <u>PVC slotted</u>	Depth to Bottom - Feet <u>80</u>	

RECEIVED

DEC 02 2012

BY: OLWR

Top of Lap Pipe or Reduction in Casing

FEET IF TELESCOPED OR MORE THAN ONE SCREEN: USE BACK PAGE

I certify that the well was drilled, constructed and completed in accordance with all applicable Requirements of the Mississippi Department of Environmental Quality and/or the Mississippi Department of Health regulations and state laws.


Roy V. West 0-672
Signature of Licensed Driller and License No.

11-26-02
Date

Additional Information Required On Back

If well telescopes please sketch and show depths.

GROUND LEVEL

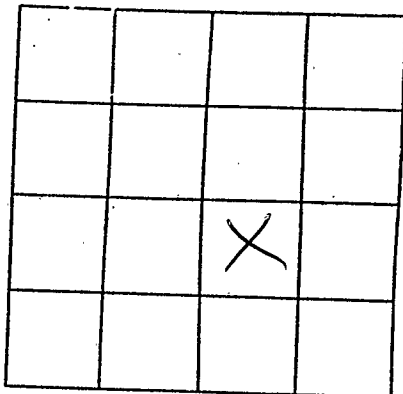

SECTION 7

Please indicate well location X.

Pump Capacity (GPM)	No. of Stages	Setting Depth
20		70 FT.

PUMP TEST

Well yielded _____ GPM with a drawdown of _____ ft. after _____ hours of pumping

LOG DATA

TYPE OF LOG RUN (Circle One): No Log Run, Electric, Gamma Ray, Density, Sonic, Neutron, Other (Describe) _____

Name of Organization Running Log _____

GEOLOGIC DATA (Office Use Only)

Surface Elev.	Geologic Unit	Unit Thickness	Depth to Top
Subs. SWL	Date	Analysis	Aquifer Test

Driller's Remarks

If more than one screen, show location of each on sketch.