

Nelly Riley 21-6

State Well Report Part 1

Mississippi Department of Environmental Quality
Office of Land and Water Resources
P.O. Box 10631
Jackson, MS 39289-0631
(601)961-5210
(601)354-6938 (fax)

For Office Use Only:

Aquifer: _____
Well #: 243
L. S. Elevation: _____
E-log #: _____

County: Wayne
Permit #: _____
Driller: John W Thompson
Date drilling completed: 8-20-08

State Law requires that this report be prepared by the driller in detail and filed with the Department within 30 days of completion of drilling of the well.

Well Owner Information	Well Location
Owner Name: <u>Massbacher</u>	Latitude: _____ Longitude: _____
Mailing Address: <u>712 Main St ste 2200</u>	Method of Lat/Long (circle one): <input type="radio"/> Conventional Survey, <input type="radio"/> USGS quad, <input type="radio"/> Hand-held GPS, <input type="radio"/> Survey-grade GPS
<u>Houston TX</u>	<u>1/4</u> <u>1/4</u> Sec <u>21</u> Twn <u>8N</u> Rng <u>6W</u>
City _____ State _____ Zip Code _____	Distance _____ Miles Direction <u>SE</u> of <u>Waynesboro</u>
Telephone No. (____) _____	

Well Data

Purpose of Well (circle one) Home Industrial Public Supply Irrigation Fish Culture Other: rig supply

Date well drilling started: 8-16-08 Date well drilling completed: 8-20-08

If flowing, method of flow regulation: Valve _____ Other (describe) _____

Static Water Level: 47 feet above or below (circle one) land surface Date measured: 8-20-08

Method of Measurement (circle one) steel tape electric tape air line other: _____

Hole depth: 683 Well depth: 660 Well grouted to a depth of 50 feet

Type of grout (circle one): Cement Bentonite Mix

Casing length: 620 feet Casing diameter: 4 inches Type of casing: PVC

Screen length: 40 feet Screen diameter: 4 inches Type of screen: PVC Slotted

Screen slot size: .010 inches Setting depth: From 620 feet to 660 feet

Type of completion (circle all applicable): Gravel packed Underreamed Telescoped Open hole Natural Development

Other (describe): _____

Top of lap pipe or reduction in casing: _____ feet. If telescoped or more than one screen, describe on back of page

Logs run (circle all applicable): No log run Electric Gamma Ray Density Sonic Neutron Other: _____

Name of organization running log(s): _____

I certify that the well was drilled, constructed, and completed in accordance with all applicable requirements of the Mississippi Department of Environmental Quality and/or the Mississippi Department of Health regulations and state laws.

John W Thompson 0-679
Print Name of Water Well Contractor and License No.

John W Thompson
Signature of Water Well Contractor

RECEIVED
AUG 27 2008
BY: OLWR


If well telescopes please sketch below and show depths

Ground Level

Description of Formations Encountered	From	To
sand & clay strips	0	121
rock & clay	121	160
clay & rock strips	160	320
sandy clay shale & rock	320	490
clay & sand strips	490	620
sand	620	660
clay & sand	660	683

If more than one screen, show location of each on sketch

Sketch the property layout and include the following: 1) the well location; 2) any permanent structures on the property that may aid in locating the well; 3) any roads, power lines, or other items that may aid in locating the property and the well; 4) indicate direction.

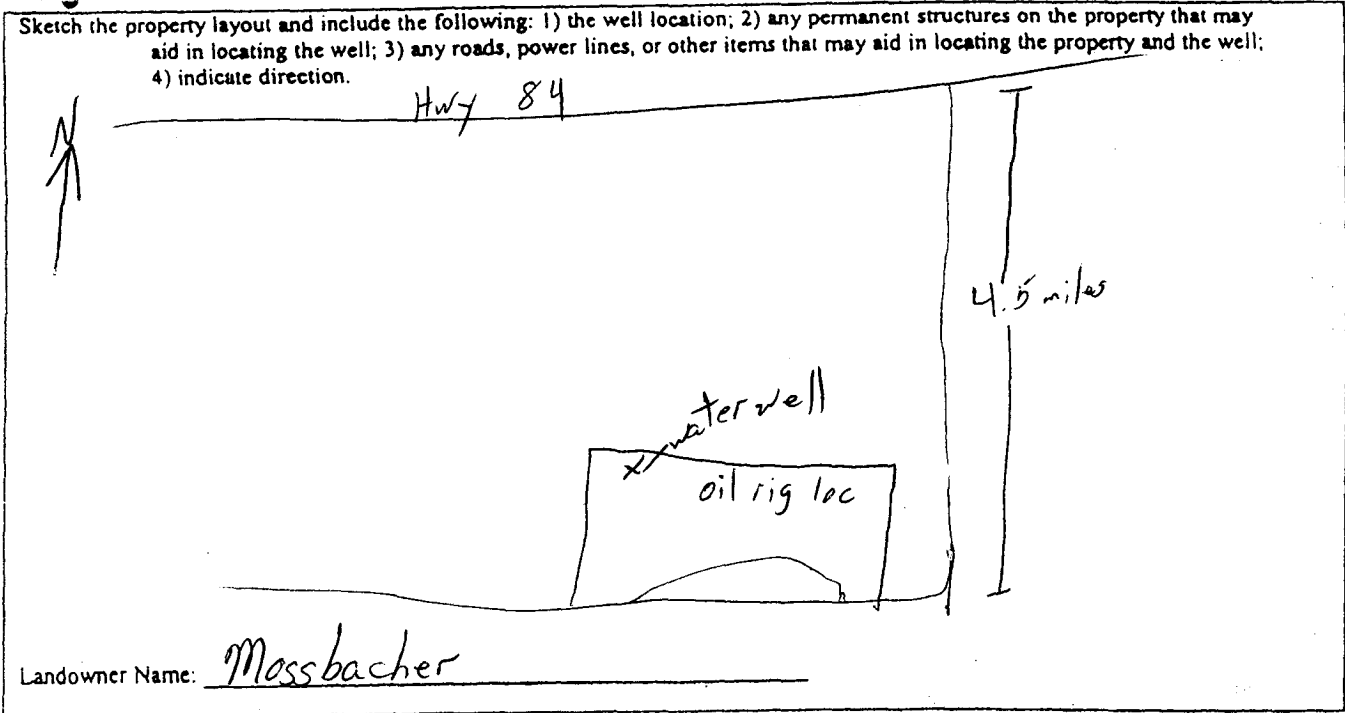

Landowner Name: Massbacher

John W. Thompson
 Signature of Water Well Contractor

STATE WELL REPORT

Part 2

Pump Installer's Completion Report
 Mississippi Department of Environmental Quality
 Office of Land and Water Resources
 P.O. Box 10631
 Jackson, MS 39289-0631
 (601)961-5210
 (601)354-6938 (fax)

For Office Use Only:

Aquifer: _____
 Well #: 243
 Elevation: _____

County: Wayne
 Permit #: _____
 Driller: John W Thompson
 Date completed: 8-20-08
Copy information from block on Part 1

This part of the report must be completed by a licensed water well contractor or a licensed pump installer. A copy of Part 1 of the report must be attached and both parts filed with the Department at the above address within 30 days of well completion.

Well Owner Information	Well Location
Owner Name: <u>Massbacher</u>	Latitude: _____ Longitude: _____
Mailing Address: <u>712 Main St ste 2200</u> <u>Houston TX</u>	Method of Lat/Long (check one): Conventional Survey _____ USGS quad _____ Hand-held GPS _____ Survey-grade GPS _____ _____ 1/4 _____ 1/4 Sec <u>21</u> T <u>8N</u> R <u>6W</u>
City _____ State _____ Zip Code _____	Distance _____ Direction _____ Nearest Town, _____ <u>2</u> Miles <u>SE</u> of <u>Waynesboro</u>
Telephone No. (____) _____	

Pump Type Circle one	Power Type Circle one
Air Lift _____ Jet _____ <u>Submersible</u>	Diesel Engine _____ Gasoline Engine _____ Natural Gas _____
Bucket _____ Piston _____ Turbine _____	<u>Electric Motor</u> _____ Hand _____ Tractor PTO _____
Centrifugal _____ Rotary _____ Flowing Well _____	Windmill _____ Other (specify): _____
Other (specify): _____	Horse Power Rating of Motor: <u>7.5</u>
Date Pump Installed: <u>8-20-08</u>	Setting Depth: <u>140</u> feet
Rated Pump Capacity: <u>85</u> Gallons Per Minute	Number of Stages: _____

Pump Test Data	Method of Measuring Water Level Circle one
Date Well Tested: <u>8-20-08</u>	Air Line _____ <u>Electric Measuring Line</u> _____ Steel Tape _____
Static Water Level (A): <u>47</u> Feet Below Land Surface	Other (specify): _____
Pumping Water Level (B): <u>98</u> Feet Below Land Surface	For flowing well, measured shut in head: _____ feet
Drawdown [(B) - (A)]: <u>51</u> Feet Below Land Surface	Well yielded <u>100</u> GPM with a drawdown of _____
Test Pumping Rate: <u>100</u> Gallons Per Minute	<u>51</u> feet after <u>4</u> hours of pumping
Duration of Pump Test (minimum 4 hours): <u>4</u> hours	

I HEREBY CERTIFY that the above statements are true to the best of my knowledge.

John W Thompson 0-679 _____
 Print Name of Pump Installer and License No. (if applicable) Signature of Pump Installer

Form: OLWR-SWR-1B

RECEIVED

AUG 27 2008

BY: OLWR