

MISSISSIPPI  
BOARD OF WATER COMMISSIONERS

416 North State Street  
Jackson, Mississippi 39201

FEB 22 1972

WATER WELL DRILLERS LOG

CLAYTON + McILWAIN

MISS.

1972 WATER WELL SER.

WAYNE

2-11

date well completed

firm name

county well located


Wayne  
0 2000  
2-11-72

LANDOWNER:	description of formations encountered	from	to
C. R. McILWAIN Route 2 WAYNESBORO (mailing address)			
WELL LOCATION: sec. <u>1</u> T. <u>3</u> R. <u>6W</u> <u>6 1/2</u> miles <u>E</u> of <u>Wilcox</u> (distance) (direction) (nearest town)			
WELL PURPOSE: <u>HOME</u> (home, irrigation, municipal, industrial)			
WELL COMPLETION DATA:			
(1) diameter (inches) <u>2"</u>			
(2) total depth (feet) <u>52'</u>			
(3) static water level (feet) <u>42'</u> below top of ground.			
(4) casing <u>PVC</u> , <u>47'</u> (material) (depth) <u>2"</u> If telescope see back. (size)			
(5) screen <u>5'</u> <u>47'</u> (length) (depth to top) <u>2"</u> <u>PVC</u> (size) (material)			
(6) pump <u>3/4</u> <u>3.5</u> (HP) (yield gpm) <u>220 AC</u> (type power)			
(7) electric log <u>no</u> (yes or no)			
(organization running log)			
(8) how well bottom plugged			

DRILLERS REMARKS: Washed out old well. Reaming + washing done by Dozier Well Serv Solar, Ada

If well telescopes please sketch and show depths.

GROUND LEVEL

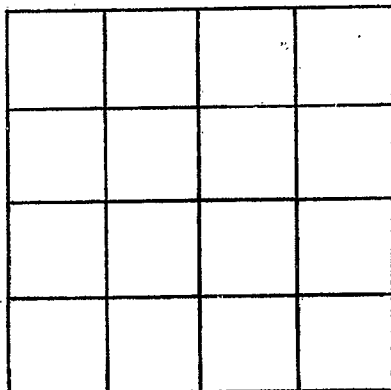

SECTION \_\_\_\_\_

Please indicate well location X.

ADDITIONAL INFORMATION

If more than one screen, show locations of each on sketch.