

Wayne
 D 2000
 11/13/75

MISSISSIPPI
 BOARD OF WATER COMMISSIONERS
 416 North State Street
 Jackson, Mississippi 39201

WATER WELL DRILLERS LOG
 McILWAIN WATER WELL SERVICE

Wayne


Nov 13, 1975 19 date well completed RT. 2 BOX 37 WAYNESBORO, MISS. 39367 county well located

LANDOWNER:	description of formations encountered	from	to
WINCHESTER METH. CHURCH			
WAYNESBORO, Miss. (mailing address)	Clay	5	12
WELL LOCATION: sec. 33 T 8 N R 6 E 13 P	Sand	12	15
5 miles SE of W'BORO (distance) (direction) (nearest town)	Clay	15	18
WELL PURPOSE: CHURCH (home, irrigation, municipal, industrial)	Sand	18	26
WELL COMPLETION DATA:			
(1) diameter (inches) 2"			
(2) total depth (feet) 26'			
(3) static water level (feet) 20' below top of ground.			
(4) casing 2" (material) 21' (depth)			
2" (size) if telescope see back.			
(5) screen 5' (length) 21' (depth to top)			
2" (size) PVC (material)			
(6) pump 1/2 (HP) 6 (yield gpm)			
110 AC (type power)			
(7) electric log no (yes or no)			
(organization running log)			
(8) how well bottom plugged			
DRILLERS REMARKS:			

NOV 25 1975
 MISS. Bd. of WATER COMMISSIONERS

If well telescopes please sketch and show depths.

GROUND LEVEL

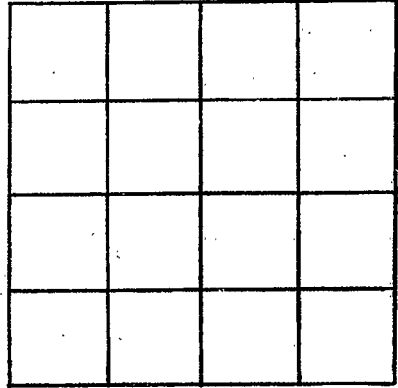

SECTION _____

Please indicate well location X.

ADDITIONAL INFORMATION

If more than one screen, show locations of each on sketch.