

Wayne

0 2003

11-26-75

MISSISSIPPI  
 BOARD OF WATER COMMISSIONERS  
 416 North State Street  
 Jackson, Mississippi 39201

WATER WELL DRILLERS LOG


McILWAIN WATER WELL SERVICE WAYNE

Nov 26, 1975  
date well completed

RT-firm name BOX 57  
WAYNESBORO, MISS. 39367

county well located

LANDOWNER:	description of formations encountered	from	to
MR. ROBERT DYE'S	Red clay	0	5
Rt 2 Waynesboro, Miss. (mailing address)	Sand	5	9
WELL LOCATION:	Clay	9	15
sec. 4 T 8 N R. 16 E 2 miles E of W'BORO (distance) (direction) (nearest town)	Blue Clay	15	24
WELL PURPOSE: HOME (home, irrigation, municipal, industrial)	Rock	24	25
WELL COMPLETION DATA:	Blue Sand	25	28
(1) diameter (inches) 2"	Blue Clay	28	40
(2) total depth (feet) 140'	Sand	40	45
(3) static water level (feet) 60' below top of ground.	Blue Clay	45	59
(4) casing PUC 114' (material) (depth)	Rock & limy clay	59	73
2" If telescope see back. (size)	Blue Clay	79	113
(5) screen NONE (length) (depth to top)	Honey Comb Rock	113	140
(size) (material)			
(6) pump 1 1/2 12 (HP) (yield gpm)			
220 AC (type power)			
(7) electric log NO (yes or no)			
(organization running log)			
(8) how well bottom plugged			
DRILLERS REMARKS:			

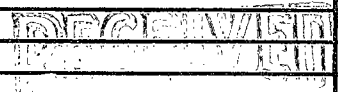


DEC 28 1975

MISS. BD. OF WATER COMM.

If well telescopes please sketch and show depths.

GROUND LEVEL

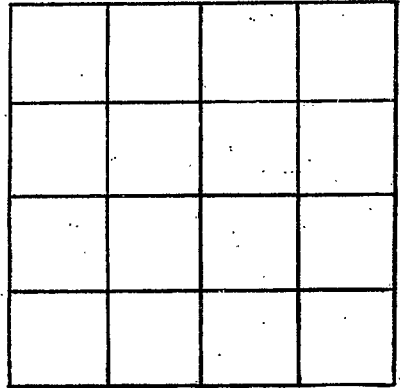

SECTION \_\_\_\_\_

Please indicate well location X.

ADDITIONAL INFORMATION

If more than one screen, show locations of each on sketch.