

Wayne
 13P
 11-28-75

MISSISSIPPI
 BOARD OF WATER COMMISSIONERS
 416 North State Street
 Jackson, Mississippi 39201

WATER WELL DRILLERS LOG

Nov 28, 1975 date well completed
 McILWAIN WATER WELL SERVICE firm name
 WAYNE county well located

LANDOWNER:
 MR. I. C. GAUVER
 RT 4 WAYNESBORO, Miss.
 (mailing address)

WELL LOCATION:
 sec. 5 T 8 N R 6 E of WAYNESBORO
 1 miles (distance) E (direction) of WAYNESBORO (nearest town)

WELL PURPOSE: HOME
 (home, irrigation, municipal, industrial)

- WELL COMPLETION DATA:
- (1) diameter (inches) 2"
 - (2) total depth (feet) 80'
 - (3) static water level (feet) 52' below top of ground.
 - (4) casing PVC 75' (material) (depth)
 2" (size) if telescope see back.
 - (5) screen 5' 75' (length) (depth to top)
 2" PVC (size) (material)
 - (6) pump 1/2 3 (HP) (yield gpm)
 110 AC (type power)
 - (7) electric log no (yes or no)
 (organization running log)
 - (8) how well bottom plugged

description of formations encountered	from	to
Red clay	0	8
Red sand some clay	8	40
Coarse Red sand	40	48
Clay, some sand	48	70
Sand	70	80


DEC 28 1975

DRILLERS REMARKS:

MISSISSIPPI BOARD OF WATER COMMISSIONERS

If well telescopes please sketch and show depths.

GROUND LEVEL

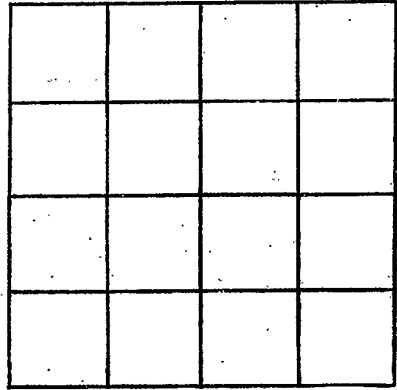

SECTION _____

Please indicate well location X.

ADDITIONAL INFORMATION

If more than one screen, show locations of each on sketch.