

WAYNE
 2005
 1-13-76

MISSISSIPPI
 BOARD OF WATER COMMISSIONERS
 416 North State Street
 Jackson, Mississippi 39201

WATER WELL DRILLERS LOG

Jan 13, 1976 19 date well completed
 McILWAIN WATER WELL SERVICE WAYNE
 RT in name BOX 37 county well located
 WAYNESBORO, MISS. 39367

LANDOWNER:
 MR. EDWIN BODIE
 WAYNESBORO, Miss
 (mailing address)

WELL LOCATION:
 sec. 20 T 8 N R 6 E W
 2 miles S of W'BORO
 (distance) (direction) (nearest town)

WELL PURPOSE: Home
 (home, irrigation, municipal, industrial)

- WELL COMPLETION DATA:
- (1) diameter (inches) 2"
 - (2) total depth (feet) 38'
 - (3) static water level (feet) 17' below top of ground.
 - (4) casing PVC 33' (material) (depth)
 2" (size) if telescope see back.
 - (5) screen 5' 33' (length) (depth to top)
 2" PVC .010 (size) (material)
 - (6) pump 3/4 8 (HP) (yield gpm)
 110 AC (type power)
 - (7) electric log no (yes or no)
- (organization running log)
- (8) how well bottom plugged

description of formations encountered	from	to
Red Clay	0	4
Yellow Clay + some sand	4	9
clay	9	10
Sand + clay streaks	10	30
Sand	30	38


RECEIVED
 McILWAIN

JAN 26 1976

DRILLERS REMARKS:

If well telescopes please sketch and show depths.

GROUND LEVEL

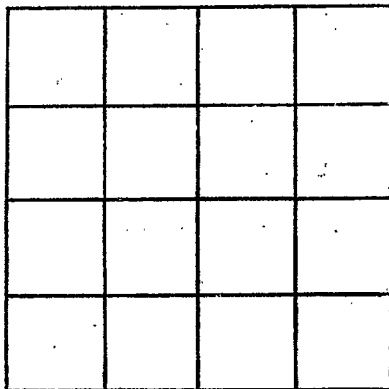

SECTION _____

Please indicate well location X.

ADDITIONAL INFORMATION

If more than one screen,
show locations of each on sketch.
