

Wayne  
 0 0 2000  
 1-17-76

MISSISSIPPI  
 BOARD OF WATER COMMISSIONERS  
 416 North State Street  
 Jackson, Mississippi 39201  
 WATER WELL DRILLERS LOG

1-17 1976 CARRS well SERV date well completed, firm name  
 WAYNE county well located

LANDOWNER: ANNIE LAND  
 RT 2 WAYNESBORO MS  
 (mailing address)  
 WELL LOCATION:  
 sec. 17 T. 8 N. R. 16 E. S. 3 W.  
 1 miles south of WABO  
 (distance) (direction) (nearest town)

description of formations encountered	from	to
TOP soil	0	1
Red SANDY CLAY	1	8
Red + PINK CLAY	8	15
COARSE Red s/w G. GRAVEL	15	22
Red pea GRAVEL	22	27
white CLAY	27	35
COARSE white SAND	35	45
white CLAY	45	47
med white SAND	47	62

WELL PURPOSE:  
 (home, irrigation, municipal, industrial)

WELL COMPLETION DATA:  
 (1) diameter (inches) 8"  
 (2) total depth (feet) 62  
 (3) static water level (feet) 45 (below above top of ground.)  
 (4) casing PVC 58 (material) (depth) (size) If telescope see back.  
 (5) screen 4' 58' (length) (depth to top) 2" PVC 8 slot (size) (material)  
 (6) pump 3/4 (HP) 6 (yield gpm) Elect (type power)  
 (7) electric log NO (yes or no)  
 (organization running log)  
 (8) how well bottom plugged 9' PVC CRP


DRILLERS REMARKS: still in SAND when quit

JAN 22 1976

MISSISSIPPI WATER COMMISSION

If well telescopes please sketch and show depths.

GROUND LEVEL

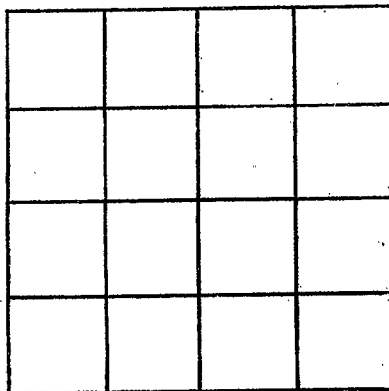

SECTION \_\_\_\_\_

Please indicate well location X.

ADDITIONAL INFORMATION

If more than one screen, show locations of each on sketch.