

WAYNE
 2008
 3-11-76

MISSISSIPPI
 BOARD OF WATER COMMISSIONERS
 416 North State Street
 Jackson, Mississippi 39201

WATER WELL DRILLERS LOG

March 11 1976 Porter Drilling & Log Wayne
 date well completed firm name county well located

LANDOWNER: James Taylor
Box 4 Waynesboro
 (mailing address)

WELL LOCATION:
 sec. 11 T. 8 N. R. 6 E.
5 miles E of Waynesboro
 (distance) (direction) (nearest town)

WELL PURPOSE: Home
 (home, irrigation, municipal, industrial)

- WELL COMPLETION DATA:
- (1) diameter (inches) 2"
 - (2) total depth (feet) 90'
 - (3) static water level (feet) 32 (below/above top of ground)
 - (4) casing PVC, 8.5'
 (material) (depth)
2" If telescope see back.
 (size)
 - (5) screen 5', 8.5'
 (length) (depth to top)
1/2" bold SS
 (size) (material)
 - (6) pump 1, 12
 (HP) (yield gpm)
elec
 (type power)
 - (7) electric log none
 (yes or no)
- (organization running log)
- (8) how well bottom plugged
back wash material

description of formations encountered	from	to
red clay	0	14
sand	14	11
clay	11	17
fine sand & clay	17	25
clay & sand	25	27
small amount clay	27	29
clay & sand	29	36
clay	36	101
fine blue sand	101	105
blue brown sand	105	123

5' 1/2" bold SS screen
 on end of case with
 back wash material on
 end & ball trap above

42' 1" PVC drop pipe


RECEIVED
 APR 19 1976

MISS. BD. OF WATER COMMISSIONERS

DRILLERS REMARKS:

If well telescopes please sketch and show depths.

GROUND LEVEL

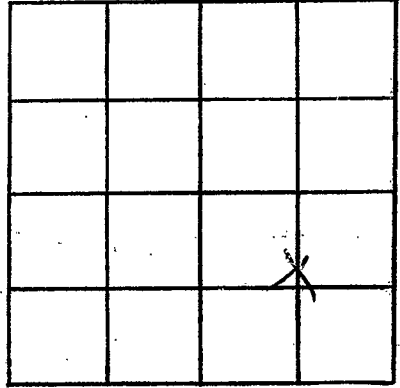

SECTION 11

Please indicate well location X.

ADDITIONAL INFORMATION

If more than one screen,
show locations of each on sketch.