

Wayne
 0 2009
 3-13-76

MISSISSIPPI
 BOARD OF WATER COMMISSIONERS
 416 North State Street
 Jackson, Mississippi 39201

WATER WELL DRILLERS LOG

MARCH 13, 1976
 date well completed


McILWAIN WATER WELL SERVICE WAYNE

RT. 1 BOX 37

county well located

WAYNESBORO, MISS 39367

LANDOWNER:	description of formations encountered	from	to
T. JORDAN			
RT 4 WAYNESBORO, Miss. (mailing address)	Red Clay	0	8
WELL LOCATION: sec. 8 T 8 N R 6 E W BORO	Pink Clay	8	20
2 miles E of W BORO (distance) (direction) (nearest town)	Sand	20	60
WELL PURPOSE: HOME (home, irrigation, municipal, industrial)			
WELL COMPLETION DATA:			
(1) diameter (inches) 2"			
(2) total depth (feet) 60			
(3) static water level (feet) 39 below top of ground.			
(4) casing PVC 56 (material) (depth)			
9" if telescope see back. (size)			
(5) screen 4' 56 (length) (depth to top)			
2" PVC .008 (size) (material)			
(6) pump 3/4 10 (HP) (yield gpm)			
110 AC (type power)			
(7) electric log NO (yes or no)			
(organization running log)			
(8) how well bottom plugged			

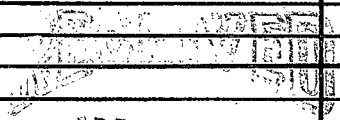


APR 20 1976

DRILLERS REMARKS:

If well telescopes please sketch and show depths.

GROUND LEVEL

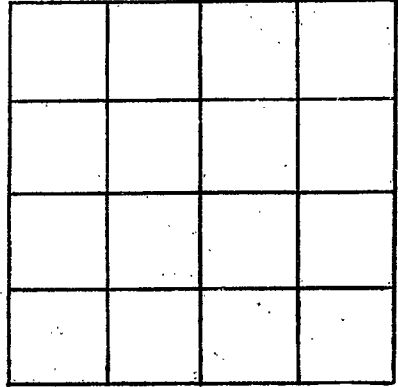

SECTION _____

Please indicate well location X.

ADDITIONAL INFORMATION

Lined area for providing additional information, consisting of approximately 25 horizontal lines.

If more than one screen, show locations of each on sketch.