

WAYNE
 2010
 3-19-76

MISSISSIPPI
 BOARD OF WATER COMMISSIONERS
 416 North State Street
 Jackson, Mississippi 39201

WATER WELL DRILLERS LOG

March 19 1976 *Robert D. Williams* *Wayne*
 date well completed firm name county well located


LANDOWNER: <i>Chester Nye</i>	description of formations encountered	from	to
<i>244 Mainesboro</i> (mailing address) WELL LOCATION: sec. <u>9</u> T. <u>8</u> N. R. <u>6</u> E. W. <u>1</u> <u>2</u> miles <u>E</u> of <u>Mainesboro</u> (distance) (direction) (nearest town) WELL PURPOSE: <u>Home</u> (home, irrigation, municipal, industrial) WELL COMPLETION DATA: (1) diameter (inches) <u>2"</u> (2) total depth (feet) <u>191</u> (3) static water level (feet) <u>80</u> <u>below</u> top of ground. (4) casing <u>steel</u> <u>146'</u> (material) (depth) <u>2'</u> If telescope see back. (size) (5) screen <u>none</u> (length) (depth to top) (size) (material) (6) pump <u>1/2</u> <u>10</u> (HP) (yield gpm) <u>elec.</u> (type power) (7) electric log <u> </u> (yes or no) (organization running log) (8) how well bottom plugged <u> </u>	<u>clay</u> <u>sand + clay</u> <u>clay</u> <u>blue clay</u> <u>blue clay</u> <u>blue clay</u> <u>blue clay</u> <u>blue clay</u> <u>blue clay</u> <u>blue clay</u>	<u>0</u> <u>15</u> <u>32</u> <u>40</u> <u>45</u> <u>53</u> <u>77</u> <u>77</u> <u>76</u> <u>147</u>	<u>15</u> <u>22</u> <u>40</u> <u>45</u> <u>72</u> <u>77</u> <u>76</u> <u>77</u> <u>147</u>

RECEIVED
 APR 19 1976

MISSISSIPPI WATER COMMISSION

If well telescopes please sketch and show depths.

GROUND LEVEL

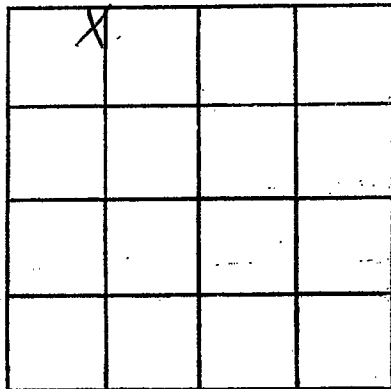

SECTION 9

Please indicate well location X.

ADDITIONAL INFORMATION

If more than one screen, show locations of each on sketch.