

Waynesboro
 12012
 5-17-76

MISSISSIPPI
 BOARD OF WATER COMMISSIONERS
 416 North State Street
 Jackson, Mississippi 39201

WATER WELL DRILLERS LOG

May 17 1976 Roots Drilling & Log Wayne
 date well completed firm name county well located

LANDOWNER: Ralph Moreland
RT 4 Box 684
Waynesboro Miss
 (mailing address)

WELL LOCATION:
 sec 13 T 8 N 5 R 6 E
7 miles East of Waynes
 (distance) (direction) (nearest town)

WELL PURPOSE: Home
 (home, irrigation, municipal, industrial)


WELL COMPLETION DATA:
 (1) diameter (inches) 2"
 (2) total depth (feet) 91'
 (3) static water level (feet) 60 (below/above top of ground)
 (4) casing P.V.C. 86'
 (material) (depth)
2" If telescope see back.
 (size)
 (5) screen 5' 86'
 (length) (depth to top)
1/2" Galv S.S.
 (size) (material)
 (6) pump 3/4 5
 (HP) (yield gpm)
elec
 (type power)
 (7) electric log no
 (yes or no)
 (organization running log)

description of formations encountered	from	to
red clay	0	18
sand & clay	18	30
clay	30	45
sand & clay	45	55
fine sand	55	72
crushed shell sand	72	78
loose clay	78	83
course white sand	83	91
well some near gravel at bottom		
5' 1/2" 8 slot S.S.		
screwed on end of casing with back wash valve on end of shaft		
82' 1" P.V.C. casing pipe		

DRILLERS REMARKS:
 MAY 24 1976
 MISS. RD. OF WATER COMMISSIONERS

If well telescopes please sketch and show depths.

GROUND LEVEL

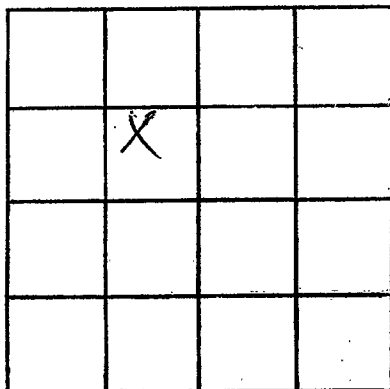

SECTION 13

Please indicate well location X.

ADDITIONAL INFORMATION

If more than one screen,
show locations of each on sketch.