

Wayne
 2013
 5/19/76

MISSISSIPPI
 BOARD OF WATER COMMISSIONERS
 416 North State Street
 Jackson, Mississippi 39201

WATER WELL DRILLERS LOG

May 19 1976 Prote Drilling & Log Wayne
 date well completed firm name county well located

LANDOWNER: J. C. Sanner
Creekside Dr.
Waynesboro Miss
 (mailing address)

WELL LOCATION:
 sec. 18 T. 8 N. R. 6 E.
1/2 miles S.E. of Waynesboro
 (distance) (direction) (nearest town)

WELL PURPOSE: domestic
 (home, irrigation, municipal, industrial)

- WELL COMPLETION DATA:
- diameter (inches) 2"
 - total depth (feet) 111'
 - static water level (feet) 61' ^{below}/_{above} top of ground.
 - casing P.V.C. 106'
 (material) (depth)
2" If telescope see back.
 (size)
 - screen 5' 106'
 (length) (depth to top)
1/4" galv SS
 (size) (material)
 - pump 1 7 1/2
 (HP) (yield gpm)
elec.
 (type power)
 - electric log no
 (yes or no)
- (organization running log)
- (8) how well bottom plugged back wash valve

description of formations encountered	from	to
clay & sand	0	8
clay	8	15
sand & fine gravel	15	34
blue clay	34	46
rock strata	46	55
blue clay	55	72
rock strata	72	92
clay	92	94
sand	94	95
clay	95	97
fine grey sand	97	111
rest of well in sand		
5' 1/4" galv SS screen		
on end of cas with back		
wash on end of well		
5' above		
82' 1" P.V.C. casing		




MAY 24 1976

DRILLERS REMARKS:

MISS. BD. OF WATER COMMISSIONERS

If well telescopes please sketch and show depths.

GROUND LEVEL

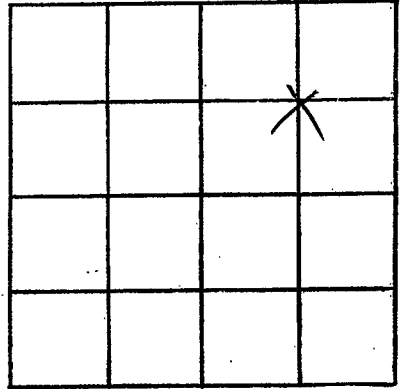

SECTION 18

Please indicate well location X.

ADDITIONAL INFORMATION

If more than one screen,
show locations of each on sketch.