

WAYNE
Φ 2014
5-20-76

MISSISSIPPI
 BOARD OF WATER COMMISSIONERS
 416 North State Street
 139 Jackson, Mississippi 39201

WATER WELL DRILLERS LOG

May 20, 1976 19 McILWAIN WATER WELL SERVICE Wayne
 date well completed RT. file no. BOX 37 county well located

WAYNESBORO, MISS. 39367

LANDOWNER:
Donald Fullerson
Rt 4 Waynesboro, Miss.
 (mailing address)

description of formations encountered	from	to
<u>Sandy Clay</u>	<u>0</u>	<u>5</u>
<u>Sand</u>	<u>5</u>	<u>12</u>
<u>Clay</u>	<u>12</u>	<u>18</u>
<u>Sand</u>	<u>18</u>	<u>32</u>
<u>Blue Clay</u>	<u>32</u>	<u>38</u>
<u>Timmy Rock + Clay</u>	<u>38</u>	<u>60</u>
<u>Blue Clay</u>	<u>60</u>	<u>107</u>
<u>Honey Comb Rock</u>	<u>107</u>	<u>134</u>

WELL LOCATION:
 sec. 8 T. 8 N R. 6 E
2 miles E of W'BORO
 (distance) (direction) (nearest town)

WELL PURPOSE: Home
 (home, irrigation, municipal, industrial)

- WELL COMPLETION DATA:
- (1) diameter (inches) 4" x 2"
 - (2) total depth (feet) 134'
 - (3) static water level (feet) 30' below top of ground. 4" - 34' above
 - (4) casing PVC 2" - 10.7
 (material) (depth)
 - (size) if telescope see back.
 - (5) screen None
 (length) (depth to top)
 - (size) (material)
 - (6) pump 3/4 10
 (HP) (yield gpm)
 - 220 AC
 (type power)
 - (7) electric log no
 (yes or no)

(organization running log)

(8) how well bottom plugged


DRILLERS REMARKS:

JUN 1 1976

MISSISSIPPI BOARD OF WATER COMMISSIONERS

If well telescopes please
sketch and show depths.

GROUND LEVEL

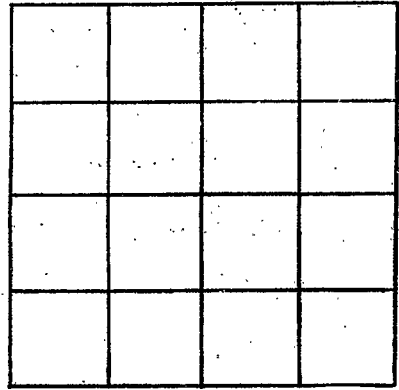

SECTION _____

Please indicate well location X.

ADDITIONAL INFORMATION

If more than one screen,
show locations of each on sketch.