

WAYNE  
2015  
6-12-76

MISSISSIPPI  
 BOARD OF WATER COMMISSIONERS  
 416 North State Street  
 Jackson, Mississippi 39201

WATER WELL DRILLERS LOG

6/12/76 1976 Cow's Well Dr. Wayne  
 date well completed firm name county well located

LANDOWNER: J. A. Brett

description of formations encountered from to

Pl. 4  
Waynesboro, Ms.  
 (mailing address)

description of formations encountered	from	to
Top soils	0	1
Red sandy clay	1	10
" sand	10	15
" fine gravel	15	25
Coarse W. sand	25	35
W. clay	35	38
Coarse W. sand	38	55
W. fine gravel	55	65
Coarse W. sand	65	70
Geo gravel	70	75

WELL LOCATION:  
 sec. 13 T. 48N S. R. 6E W.  
14 miles N. of Denham  
 (distance) (direction) (nearest town)

WELL PURPOSE:  
 (home) irrigation, municipal, industrial

WELL COMPLETION DATA:


- (1) diameter (inches) 2"
- (2) total depth (feet) 75'
- (3) static water level (feet) 42  below  above top of ground.
- (4) casing P.V.C. 70'  
 (material) (depth)
- If telescope see back.  
 (size)
- (5) screen 5' 70'  
 (length) (depth to top)
- 2" 18pt P.V.C.  
 (size) (material)
- (6) pump 1 8  
 (HP) (yield gpm)
- Electric  
 (type power)
- (7) electric log NO  
 (yes or no)
- (organization running log)
- (8) how well bottom plugged 2"  
P.V.C. cap.

DRILLERS REMARKS:  
Drill in same  
when  
gent.

MISSISSIPPI BOARD OF WATER COMMISSIONERS  
 JUN 16 1976  
 MISSISSIPPI BOARD OF WATER COMMISSIONERS

If well telescopes please sketch and show depths.

GROUND LEVEL

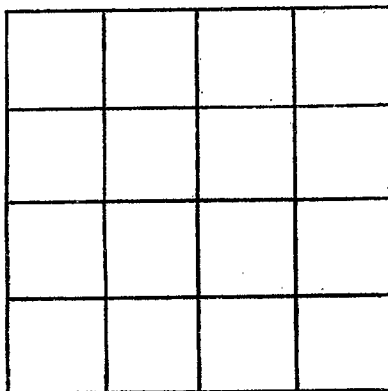

SECTION \_\_\_\_\_

Please indicate well location X.

ADDITIONAL INFORMATION

If more than one screen, show locations of each on sketch.