

WAYNE
 2016
 6-17-76

MISSISSIPPI
 BOARD OF WATER COMMISSIONERS
 416 North State Street
 Jackson, Mississippi 39201

WATER WELL DRILLERS LOG

13P
 McILWAIN WATER WELL SERVICE WAYNE

June 17, 1976 19 RT. 2 BOX 37 county well located
 date well completed firm name WAYNESBORO MISS 39267


LANDOWNER:	description of formations encountered	from	to
TOM RICH			
Waynesboro, Miss. (mailing address)	Red Sand	8	12
WELL LOCATION:	Coarse Sand	12	22
sec. 20 T 8 N R 6 E	Blue Clay	22	26
2 miles SE of W'BORO	Fine Sand & Clay	26	39
(distance) (direction) (nearest town)	med. Sand	39	44
WELL PURPOSE: HOME			
(home, irrigation, municipal, industrial)			
WELL COMPLETION DATA:			
(1) diameter (inches) 2"			
(2) total depth (feet) 44'			
(3) static water level (feet) 27' below top of ground			
(4) casing PVC 40' (material) (depth)			
2" (size) if telescope see back.			
(5) screen 4' 40' (length) (depth to top)			
2" PVC (size) (material)			
(6) pump 1 8 (HP) (yield gpm)			
220 AC (type power)			
(7) electric log NO (yes or no)			
(organization running log)			
(8) how well bottom plugged			
DRILLERS REMARKS:			

RECEIVED
 JUL 14 1976

MISS. BD. OF WATER COMMISSIONERS

If well telescopes please sketch and show depths.

GROUND LEVEL

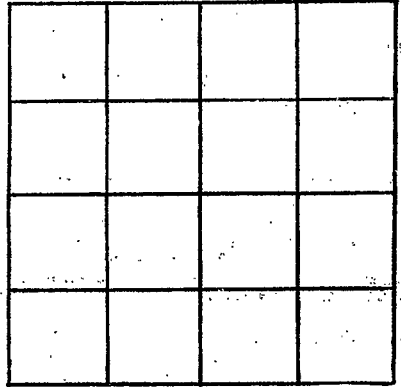

SECTION _____

Please indicate well location X.

ADDITIONAL INFORMATION

If more than one screen, show locations of each on sketch.